


TOWNSHIPS 5&6 NORTH, RANGE 35 EAST, W.M.

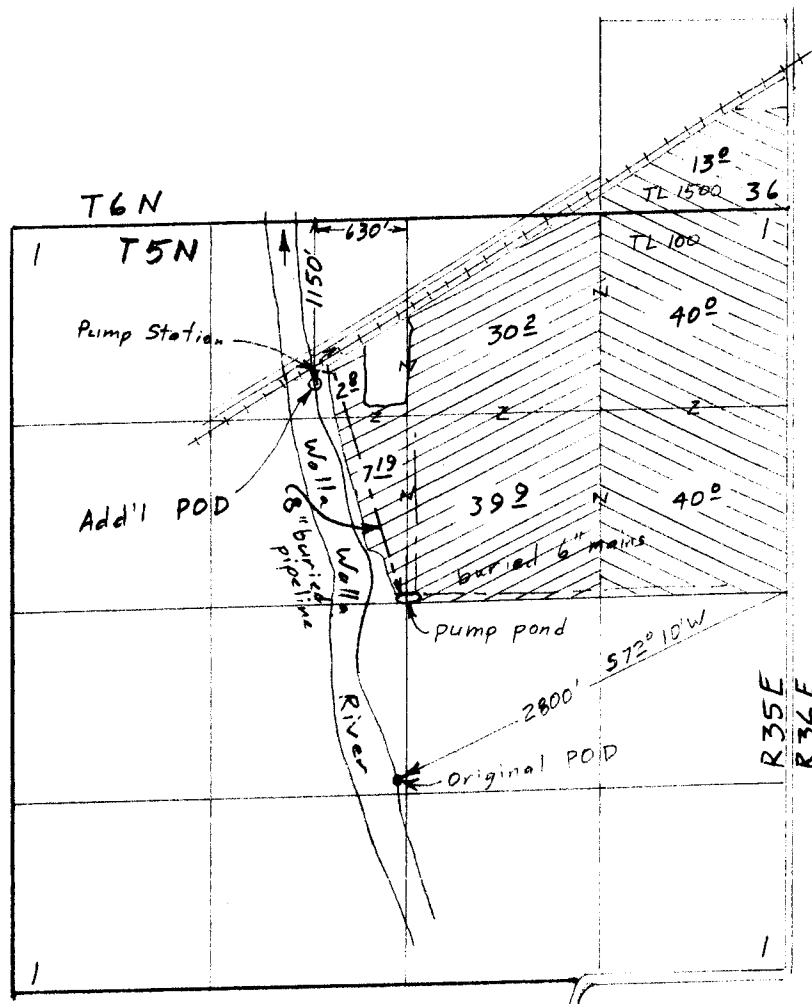


Scale 1" = 1320'

Surveyed August 30, 2003

- ⊙ 1897 (80<sup>±</sup> acres)
- ⊙ July 12, 1912 (93<sup>±</sup> acres)

Claim of Beneficial Use Map  
for  
J. Frank Schmidt & Son Co.

T-9121

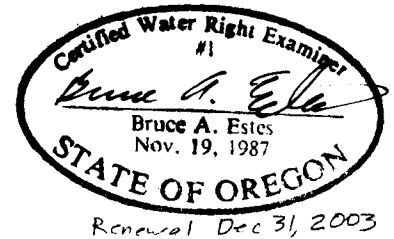

This map is for the purpose of locating a water right only and has no intent to provide legal dimensions or the location of property lines.

**ESTES SURVEYS, LLC**  
 PO Box 17519      60382 Arnold Rd  
 Salem, OR 97305-7519      Bend, OR 97702  
 (503) 585-7593      (541) 382-7391