


Township 5 South, Range 2 West, W.M.

Section 24


Tax Lot No. 1800/44363000

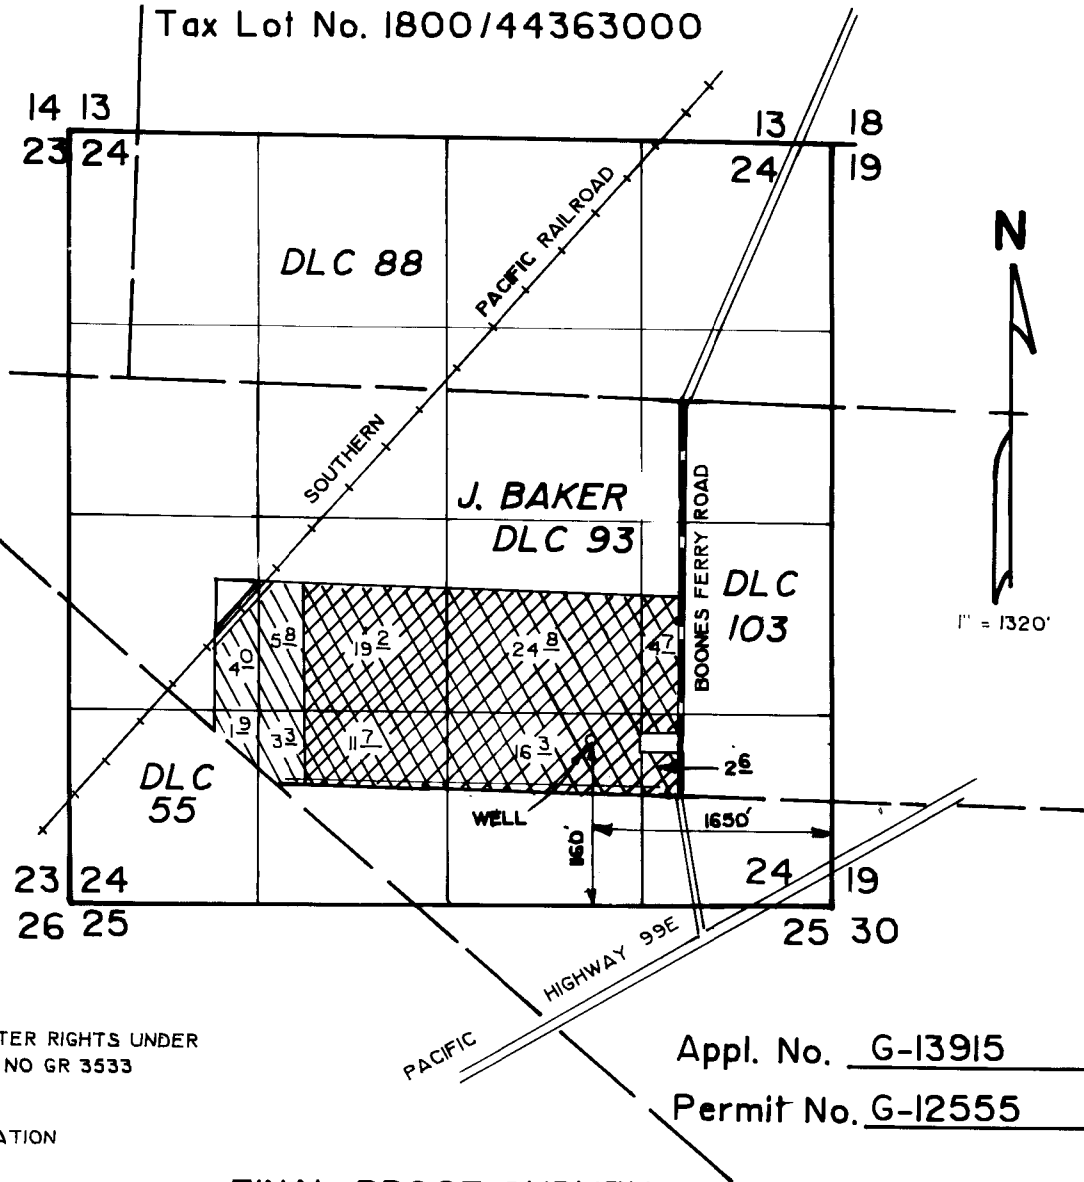

Appl. No. G-13915

Permit No. G-12555

FINAL PROOF SURVEY
for
GESCHWILL FARMS

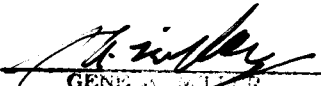Certified Water Right Examiner
 #380 WRE

 GENERAL EXAMINER
 May 13, 1998
 STATE OF OREGON
 12-8-98

THIS MAP WAS PREPARED FOR THE PURPOSE OF IDENTIFYING THE LOCATION OF A WATER RIGHT ONLY AND IS NOT INTENDED TO PROVIDE LEGAL DIMENSIONS OR LOCATION OF PROPERTY OWNERSHIP RIGHTS.