

# Township 5 South, Range 1 West, W.M.

## Portions of Sections 19 and 20


AUG 20 1994

RECORDED

TAX LOT NO. 400/43480080  
TAX LOT NO. 700/4344000




TAX LOT NO. 600/43420000  
TAX LOT NO. 100/43450001

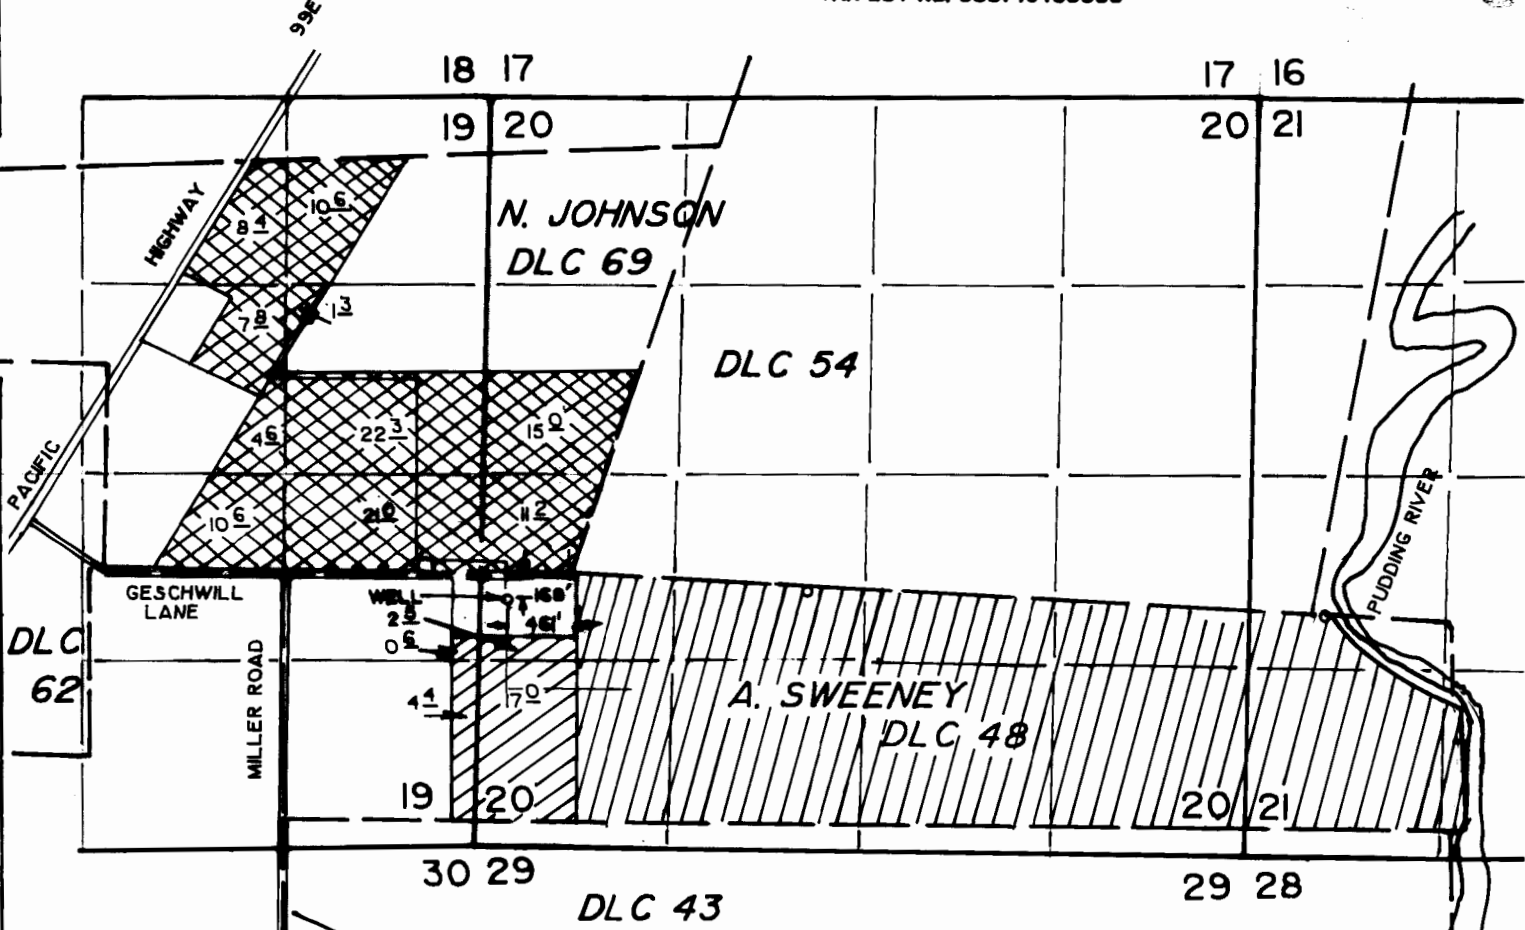TAX LOT NO. 200/43480000  
TAX LOT NO. 300/43408000



App. No. G-13920

Permit No. G-12658


-  EXISTING WATER RIGHTS UNDER CERTIFICATE NO. GR 2954
-  NEW APPLICATION
-  EXISTING WATER RIGHTS UNDER CERTIFICATES NO. 20016 and 62033

FINAL PROOF SURVEY  
for

GESCHWILL FARMS



1" = 1320'

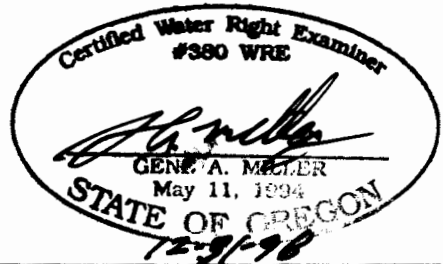

THIS MAP WAS PREPARED FOR THE PURPOSE OF IDENTIFYING THE LOCATION OF A WATER RIGHT ONLY AND IS NOT INTENDED TO PROVIDE LEGAL DIMENSIONS OR LOCATION OF PROPERTY OWNERSHIP RIGHTS.