

T.16 S.R.3 W.W.M.

"CLAIM OF BENEFICIAL USE"
FINAL PROOF SURVEY
UNDER


PERMIT NO. S-52019 FILE NO. S-73999

IN NAME OF

RICHARD K & JESSIE LEE BYLUND

SURVEYED NOVEMBER 20, 2000 BY CHARLES W. GUILLE

PRIORITY DATE
APRIL 7, 1994

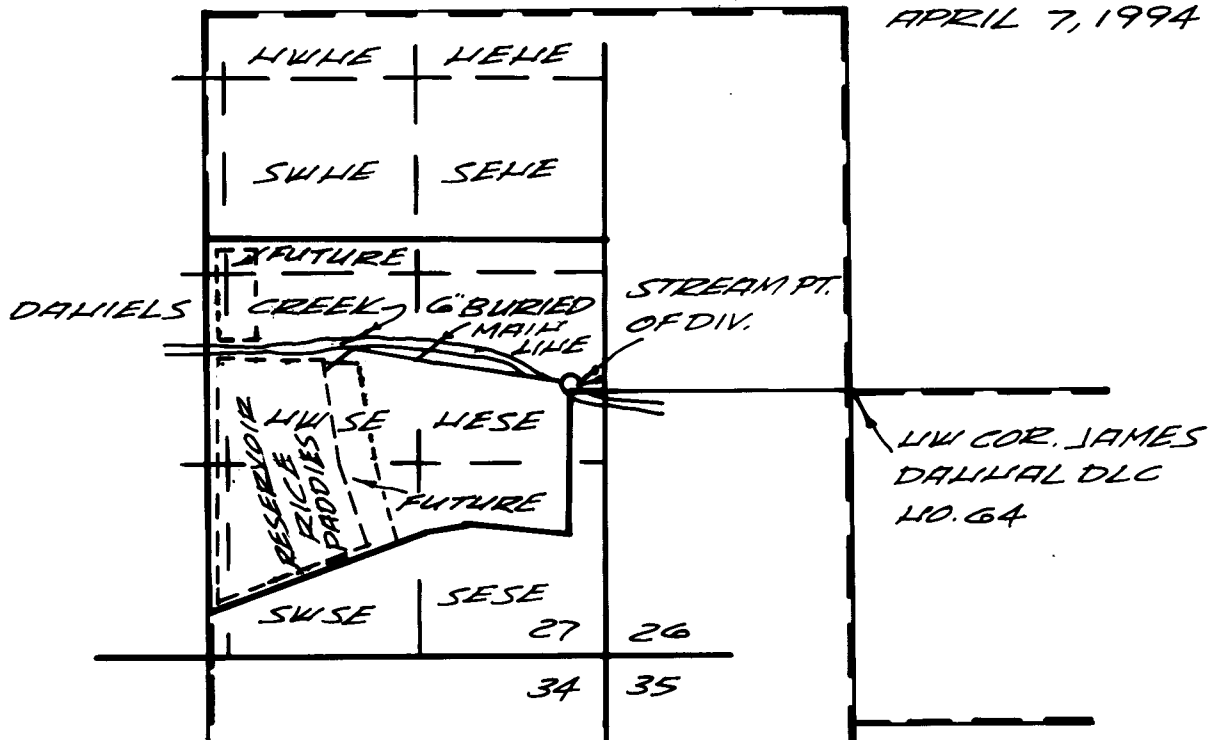

THOMAS J. VAUGHAN
DLC NO. 38

SCALE
1"=1320'

STREAM INTAKE POINT OF
DIVERSION 26.0 FEET NORTH
AND 1925.0 WEST OF THE
LW COR. DLC NO. 64

THIS MAP IS FOR WATER RIGHT
PURPOSE ONLY AND IS NOT
INTENDED TO PROVIDE
DIMENSIONS FOR LOCATING
PROPERTY BOUNDARIES.


FUTURE RESERVOIR
(RICE PADDIES)

NW/4E 6.1 AC. TOTAL
SW/4E 2.6 AC.
SE/4E 0.3 AC.
NE/4E 0.6 AC.
SW/4E 1.0 AC.

RESERVOIR
(RICE PADDIES)

NE/4E 0.7 AC.
SE/4E 1.4 AC.
NW/4E 12.4 AC.
SW/4E 16.0 AC.

CHARLES W. GUILLE
& ASSOCIATES, CO.
Land Surveying
52 Centennial Loop
Eugene, OR 97401

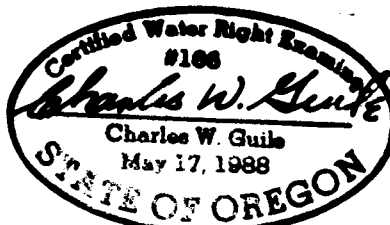

6/30/2001

2000-21