


T. 1S., R. 24E., W.M.

MORROW COUNTY

SCALE 1" = 1320'

*Modified by WRD
10-20-14 JRC*

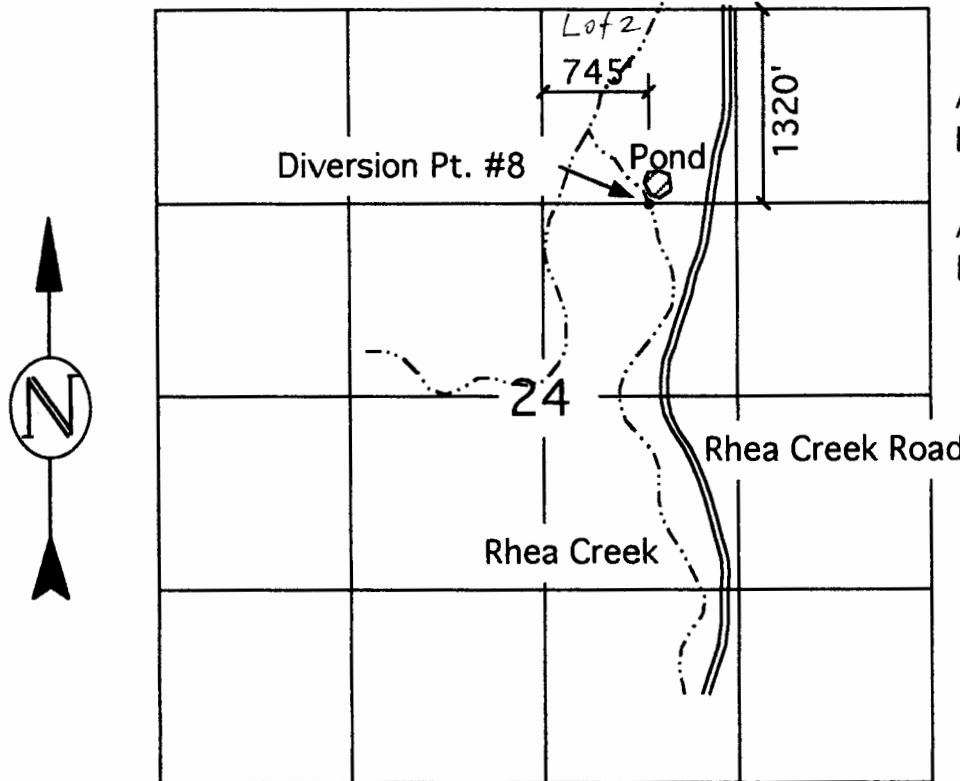

Application #S-72683
Permit #S- 52462

Application # R-72676
Permit # R-11866

Diversion Pt. & Pond Located in NW 1/4, NE 1/4 Section 24
1320 Ft South & 745 Ft East of North 1/4 Corner


WATER RIGHTS PROOF MAP

 Water Rights Found at This Location

IN NAME OF

LEE PALMER

THIS MAP IS FOR THE PURPOSE
OF IDENTIFYING THE LOCATION
OF WATER RIGHTS ONLY AND IS
NOT INTENDED TO PROVIDE THE
LEGAL DIMENSIONS OR LOCATIONS
OF PROPERTY OWNERSHIP LINES.

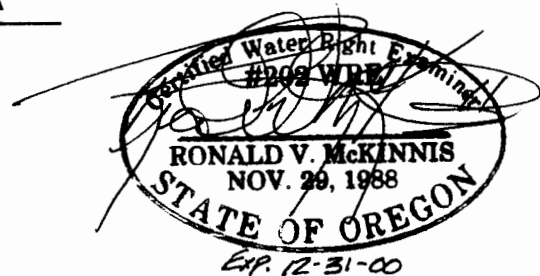

RECEIVED

AUG 31 2000

WATER RESOURCES DEPT.
SALEM, OREGON

ENGINEERING - LAND SURVEYING - WATER RIGHTS
R. V. McKINNIS ENGINEERING



79980 Prindle Loop Road
Hermiston, Oregon 97838
(541) -567-2017

