


T 32 S, R 30 E, WM

RECEIVED

OCT 02 2000

WATER RESOURCES DEPT
SALEM, OREGON

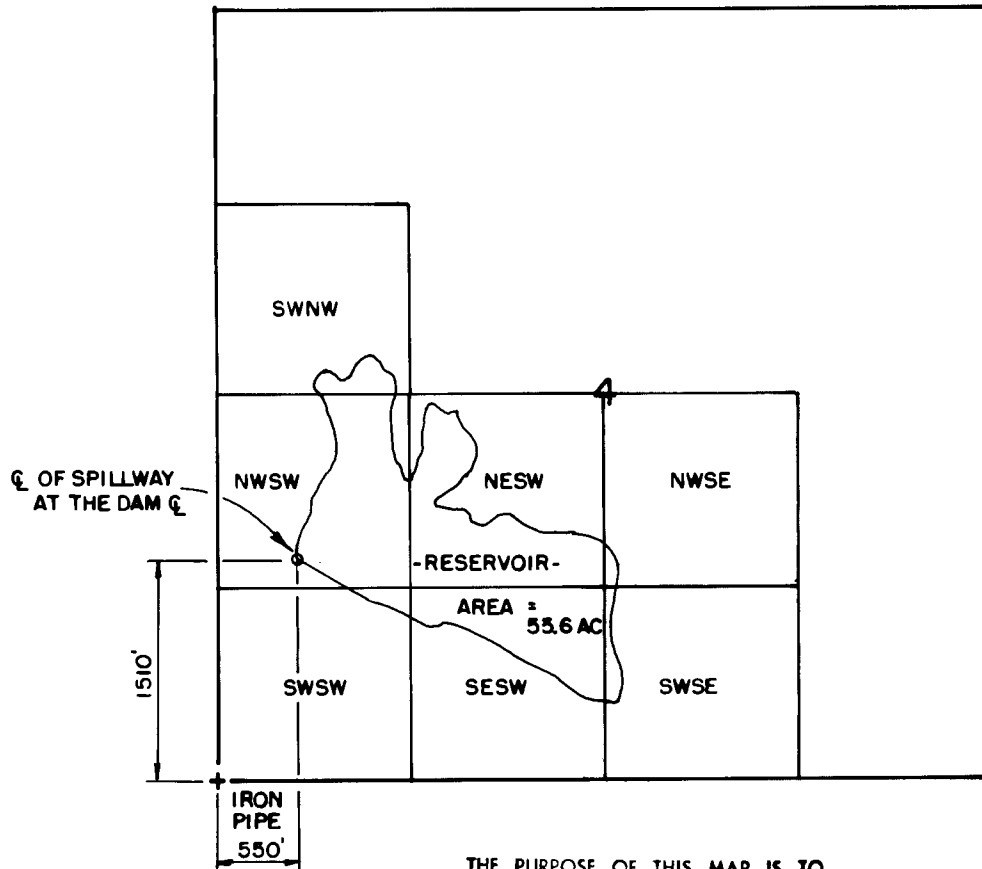

THE PURPOSE OF THIS MAP IS TO
IDENTIFY THE LOCATION OF THE
WATER RIGHT. IT IS NOT INTENDED
TO PROVIDE INFORMATION RELATIVE
TO THE LOCATION OF PROPERTY
OWNERSHIP.

	FINAL PROOF SURVEY		
	UNDER APPLICATION R-73619 PERMIT R-11824		IN THE NAME OF ROCK CREEK RANCH INC
	Scale: 4" = 1 MILE	Date: SEPT 2000	Job: 1429A
	Dsn:	M.A. PALMER & SONS, INC. ENGINEERING & SURVEYING 711 Ponderosa Village • Box 61 Burns, Oregon 97720	Sht. No.
	Drm: CHRIS		of 1
Ckd:			