


FINAL PROOF MAP FOR HOPE LAKE

APPLICATION NO. R-84203
PERMIT NO. R-12872

CLIENT: JIM HOOPER

LOCATED IN THE N.E. 1/4 OF SECTION 2
TOWNSHIP 3 SOUTH, RANGE 5 EAST, W.M.
CLACKAMAS COUNTY, OREGON
SCALE: 1" = 400' NOVEMBER 26, 2002

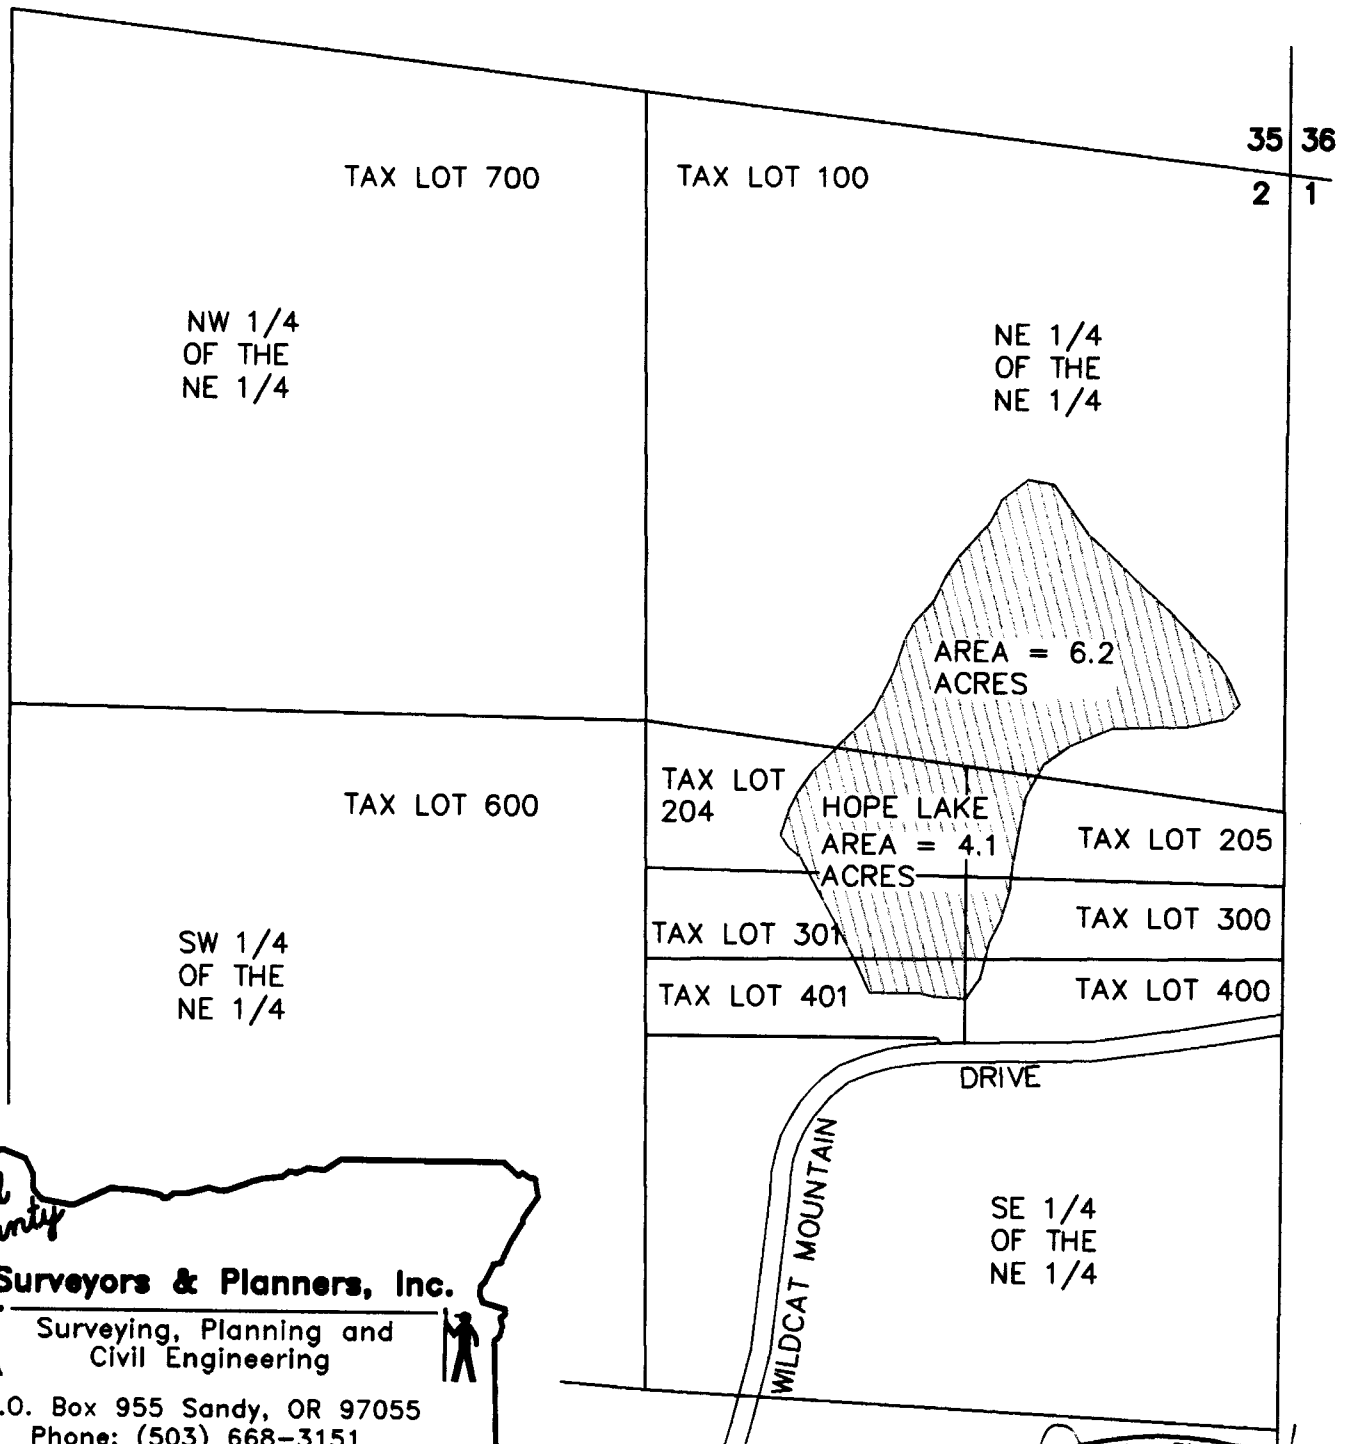


All County
Surveyors & Planners, Inc.
Surveying, Planning and
Civil Engineering
P.O. Box 955 Sandy, OR 97055
Phone: (503) 668-3151
Fax: (503) 668-4730

THIS DRAWING IS NOT A LAND SURVEY.
PROPERTY LINES AND/OR OTHER LINES
OF OCCUPATION SHOWN HEREON ARE NOT
REPRESENTED BY THE UNDERSIGNED TO
MEET ACCURACY STANDARDS OF LAND
SURVEYS.

RECEIVED

JAN 21 2003

WATER RESOURCES DEPT.
SALEM, OREGON

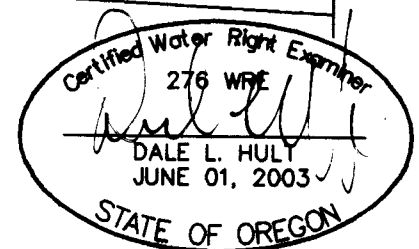

DRAWING: 02-221.DWG
DATE: 11/26/02