
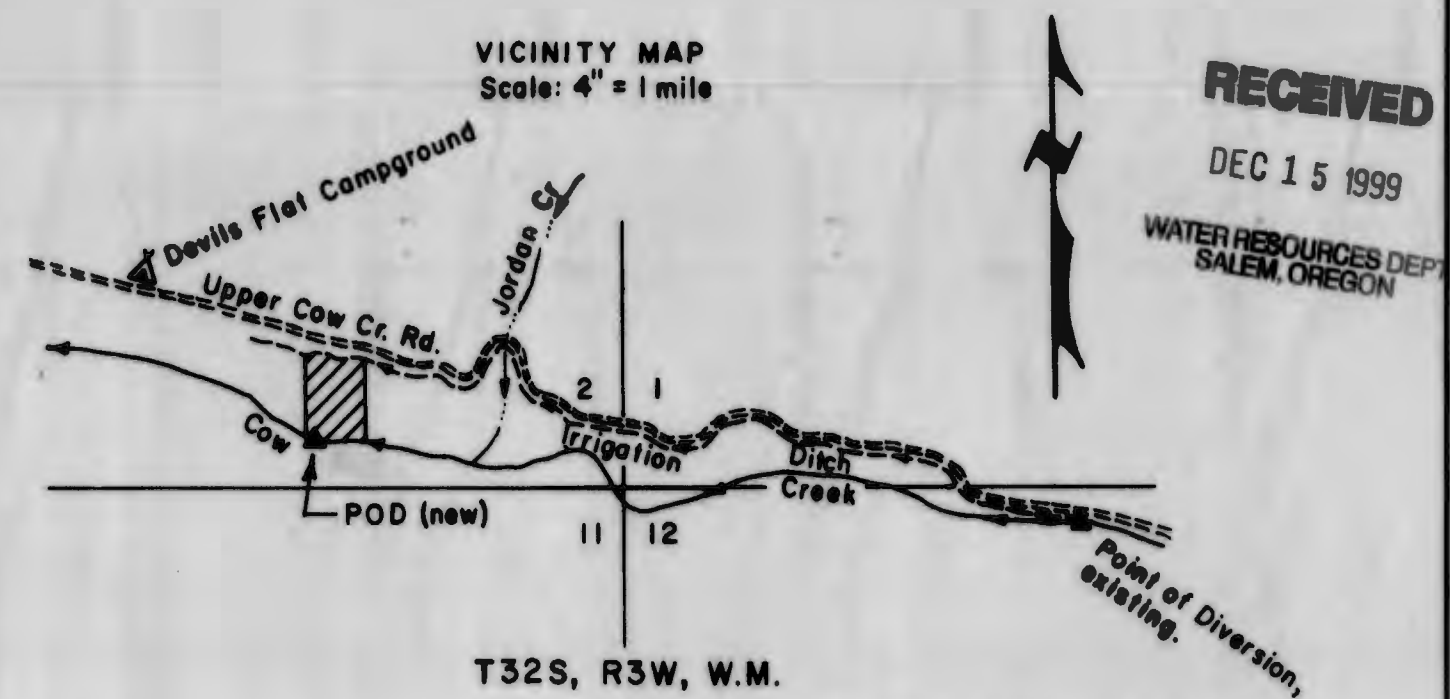


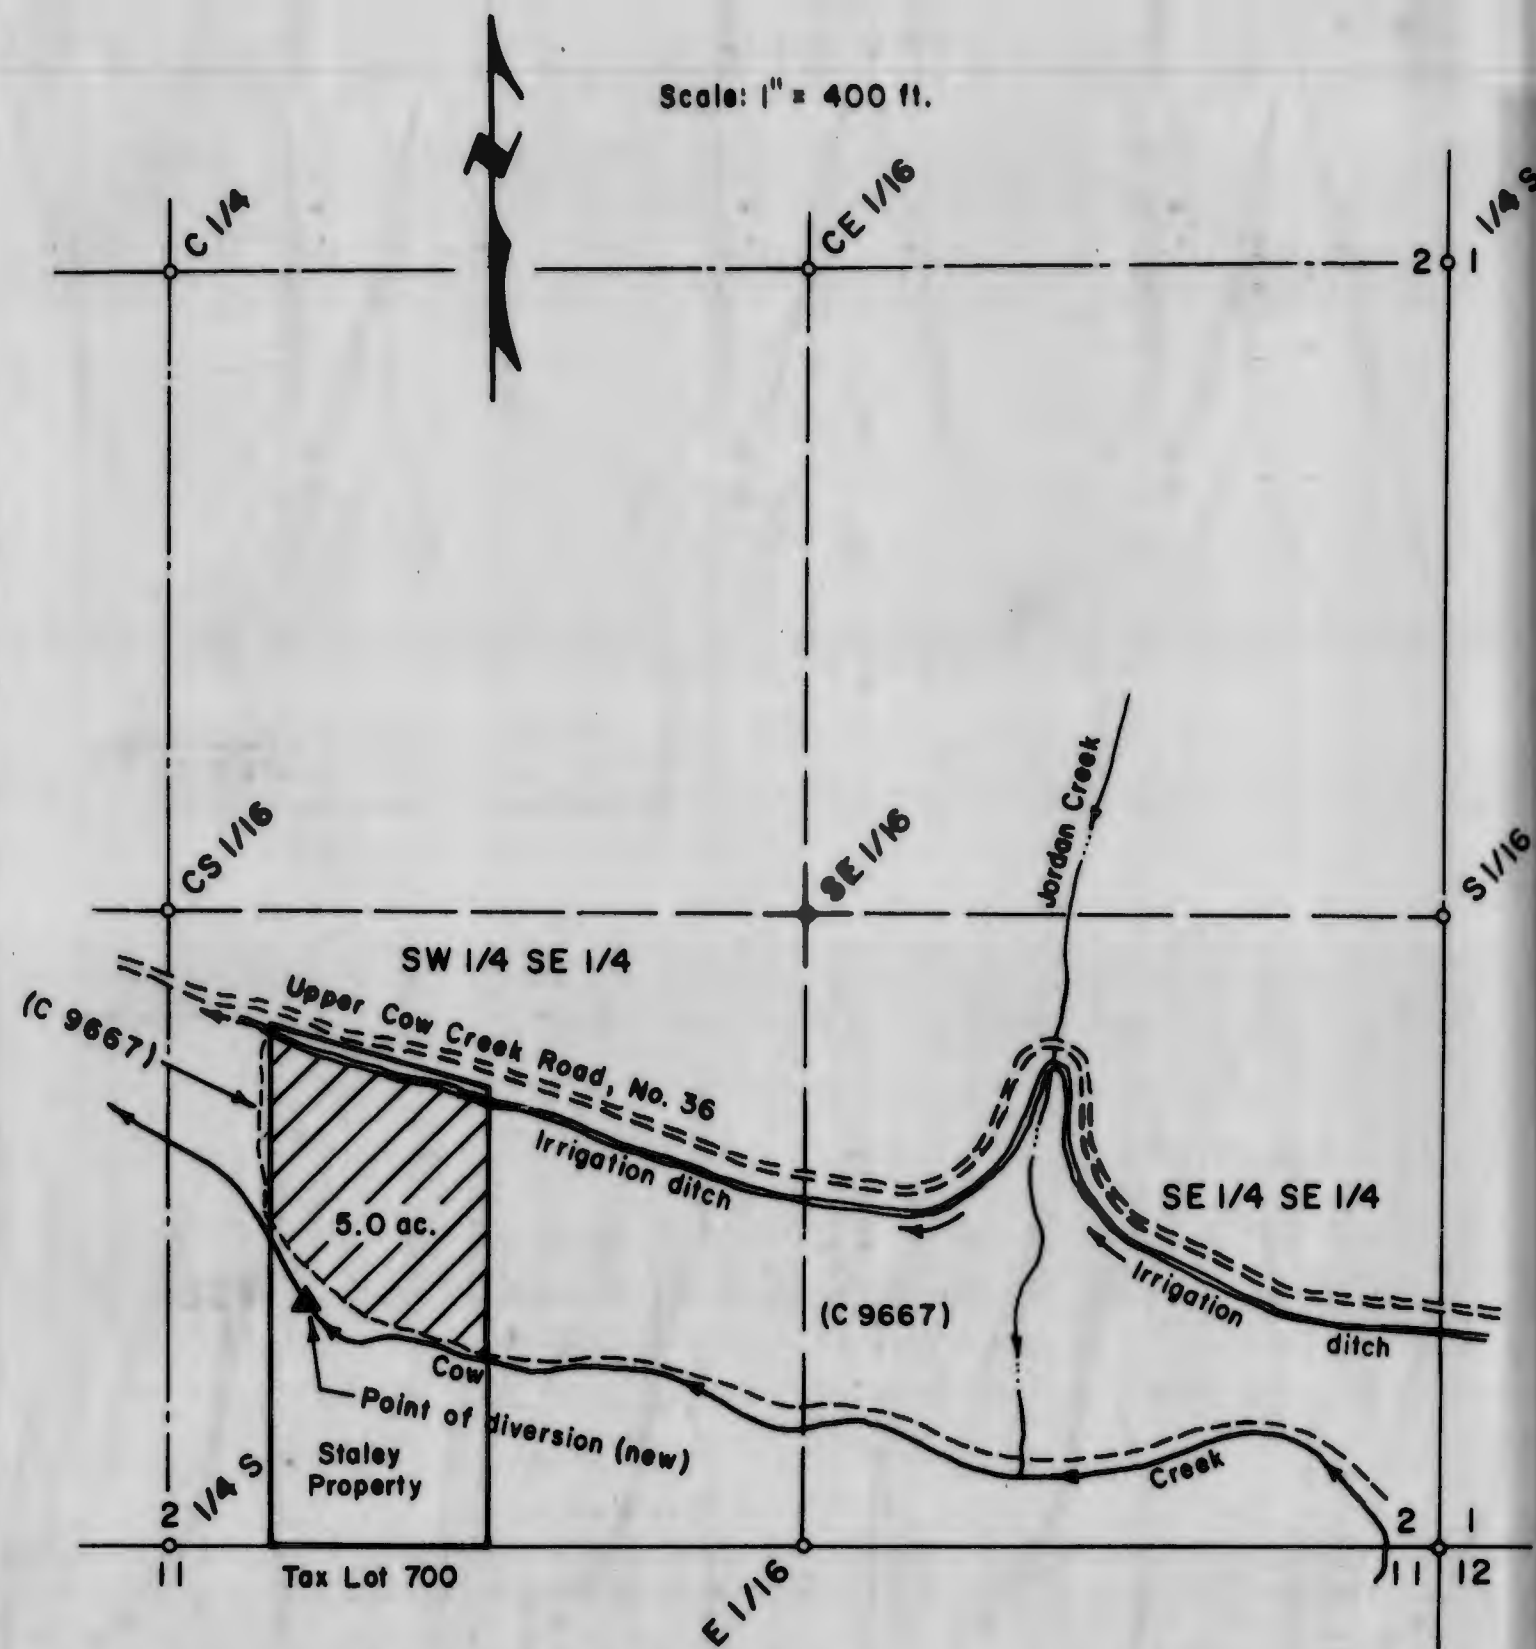

Existing POD is 250 ft. South & 3,180 ft. East of the NW corner of Section 12.

POINT OF DIVERSION TRANSFER,
COW CREEK, S 1/2 OF SECTION 2, T32S,
R3W, W.M., DOUGLAS COUNTY, OREGON

Transfer No. _____
Water Right Certificate No. 74520

For: Keith K. & Kathy M. Staley
354 Melissa Lane
Grants Pass, Oregon 97526

By: Shaner Engineering, Inc.
P.O. Box 1430
Roseburg, Oregon 97470

December 13, 1999

