

SECTION 26 & 35, T.2 N., R.3 W., W.M.
WASHINGTON COUNTY, OREGON




SCALE: 1"=400'

MAP BASE:
ASSESSORS MAP
SCALED PHOTO

RECEIVED

NOV 08 2000

WATER RESOURCES DEPT.
SALEM, OREGON

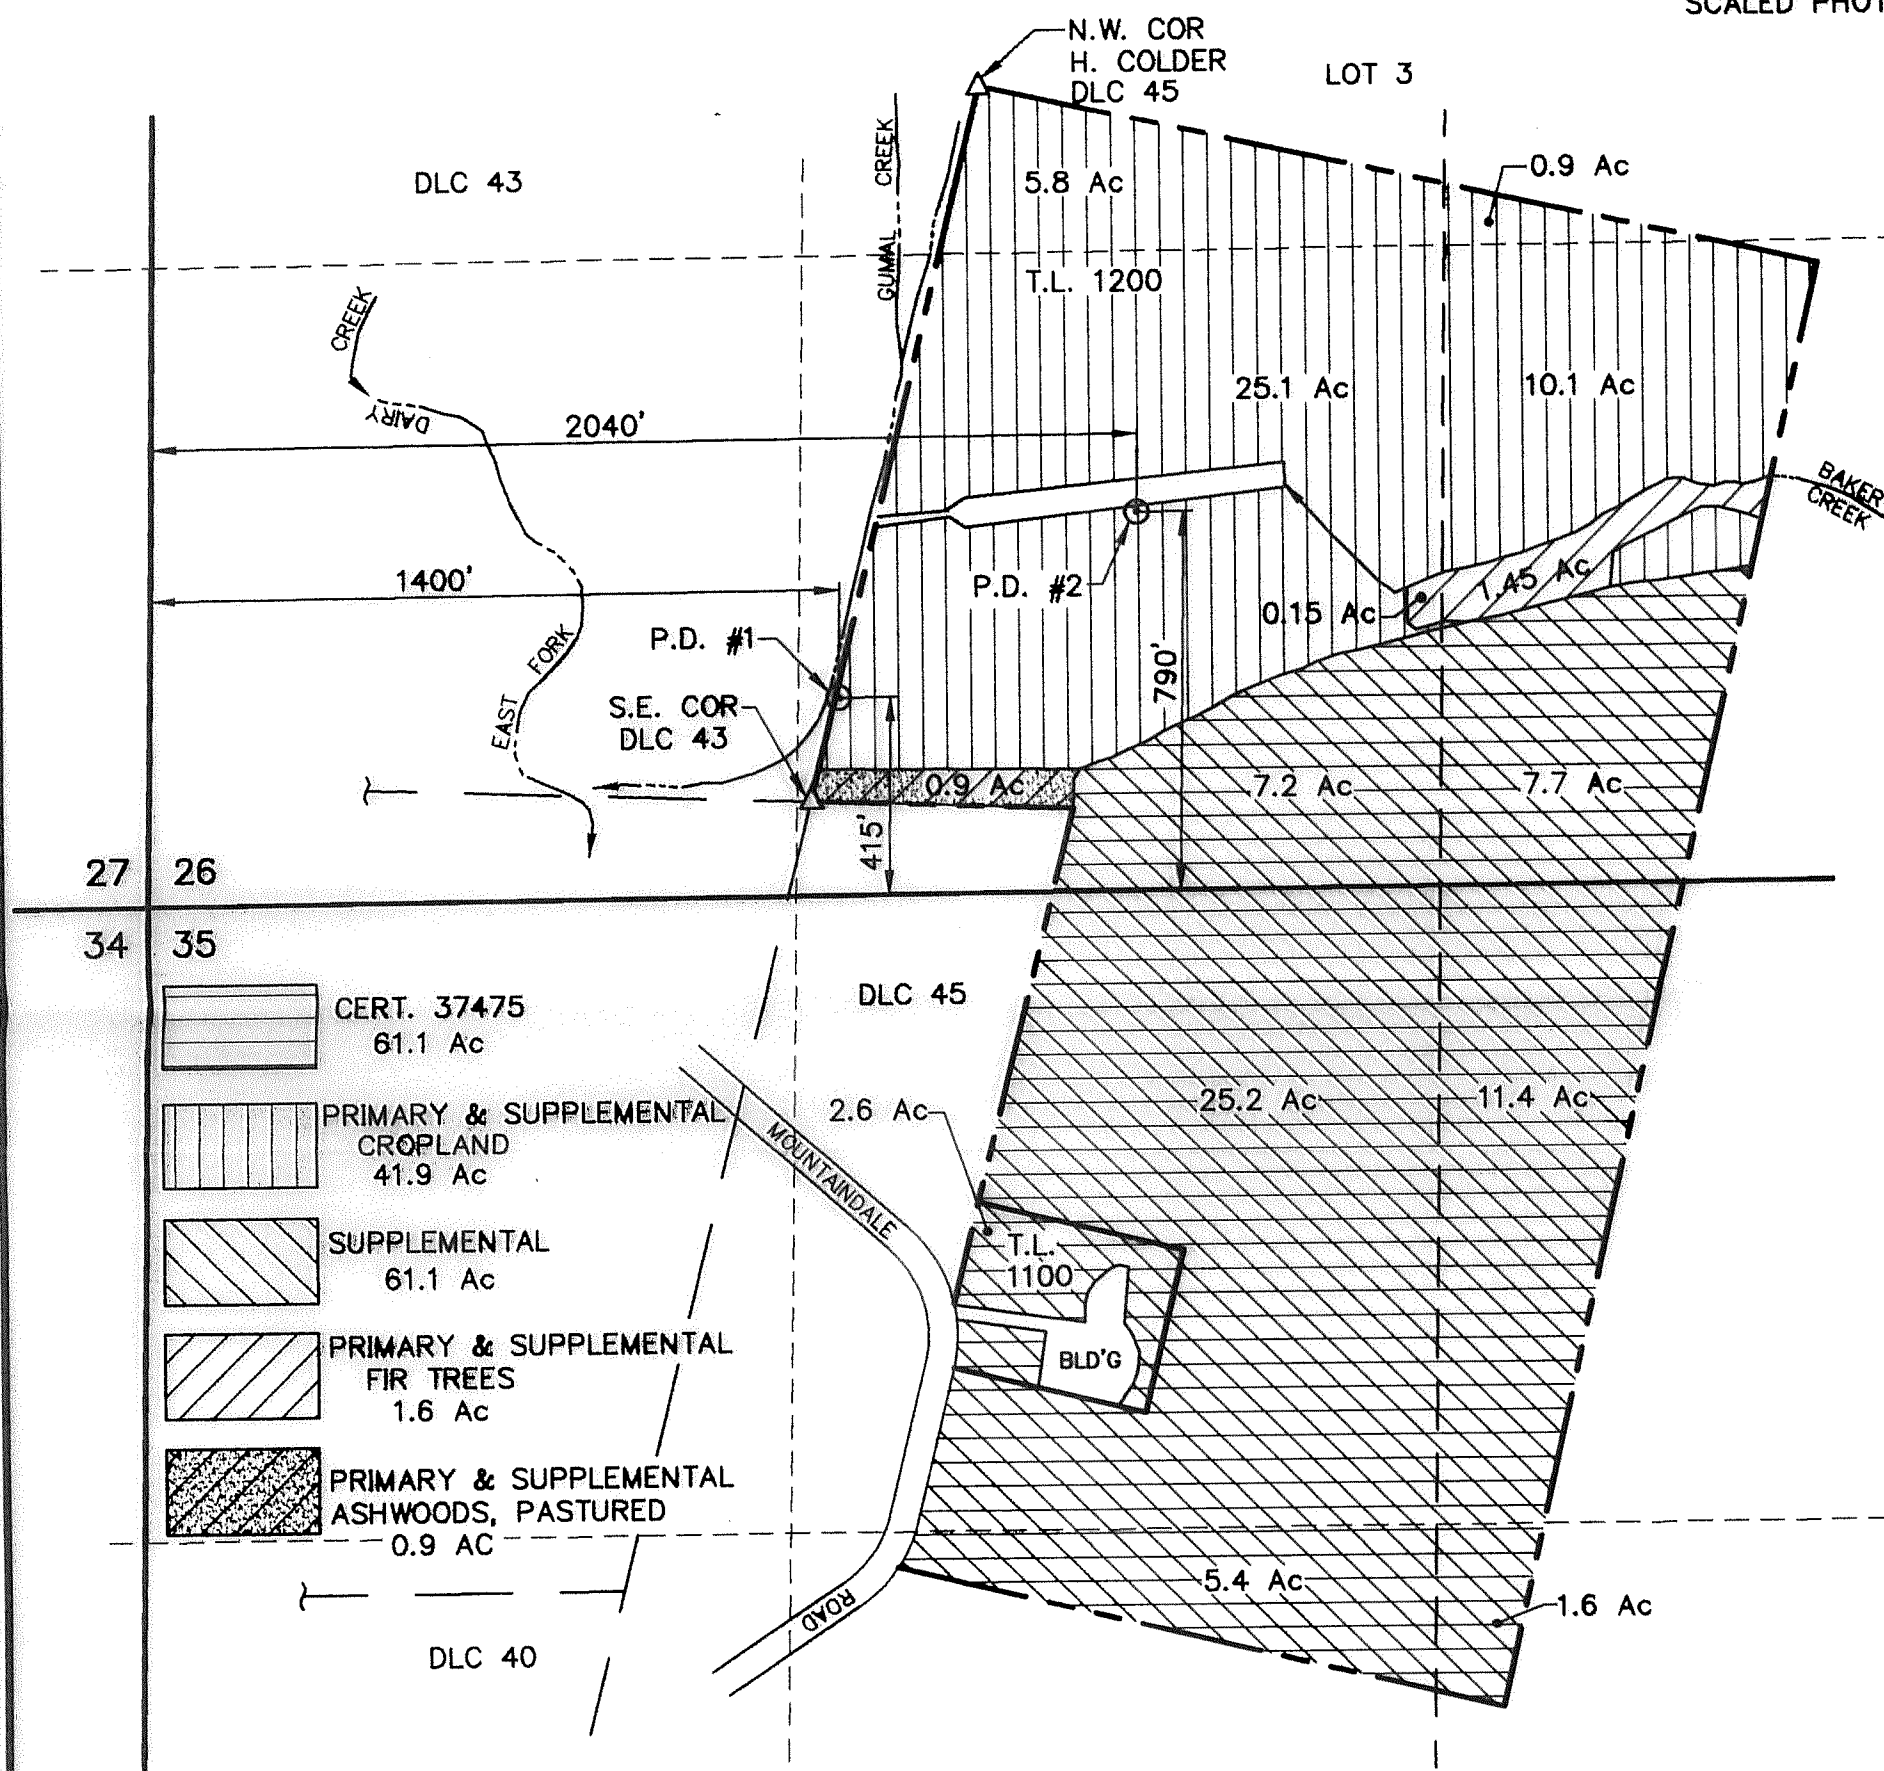


PREPARATION OF THIS MAP IS FOR THE PURPOSE OF IDENTIFYING THE LOCATION OF THE WATER RIGHT ONLY. THERE IS NO INTENT TO PROVIDE DIMENSIONS OR LOCATION OF PROPERTY OWNERSHIP LINES.

FINAL PROOF SURVEY

UNDER

APPLICATIONS PERMITS
R-71304 R-12633
S-71305 53547

SURVEYED OCTOBER 18, 2000

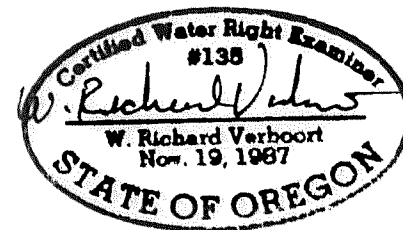

VERBOORT ENGINEERING
AGRICULTURE · CIVIL · WATER REBOURCES
HILLSBORO, OREGON

	by	date
designed	WRV	10/19/00
drawn	JER	10/19/00
checked	WRV	10/19/00
drawing no.	00-B-11	
sheet no.	1 / 1	

**DUYCK BROTHERS and
LAWRENCE DUYCK**

34203 N.W. MOUNTAINDALE RD.
NORTH PLAINS, OR 97133