

# FINAL PROOF SURVEY


APPLICATION No.: G-13701

PERMIT No.: G-12103

Applicant: Robert Morcom  
2052 2nd Avenue  
Ontario, OR 97914

SCALE: 1" = 400'

T17S, R44E, WM

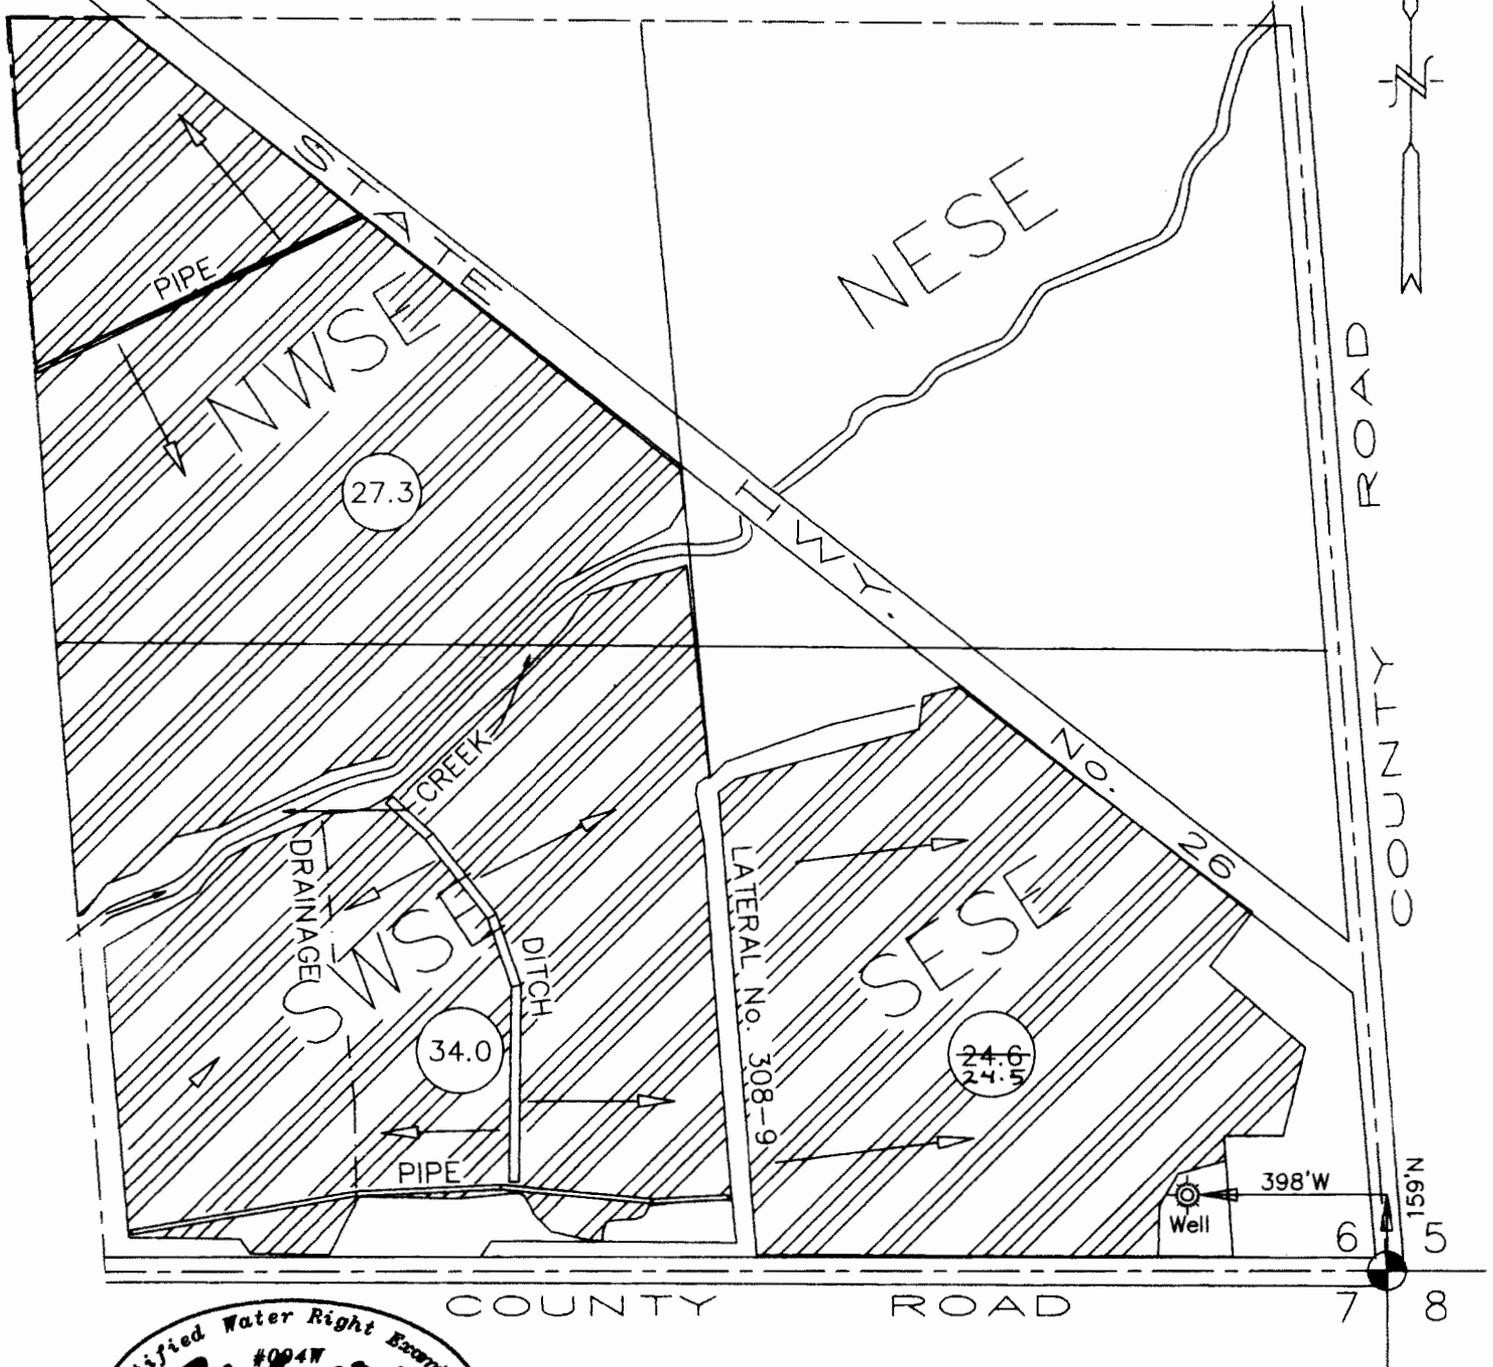

RECEIVED

007 01 1999

WATER RESOURCES DEPT  
SALEM, OREGON

This map is for the purpose of identifying the location of the water right only and has no intent to provide dimensions or location of property ownership lines.

Updated AC to 24.5 in SESE. MB/WRD 12-2-14