

SECTION 30, T.13S., R.11W., W. M.  
LINCOLN COUNTY, OREGON

RECEIVED

SEP 04 1998


WATER RESOURCES DEPT  
SALEM, OREGON




SCALE: 1" = 400'

MAP BASE:  
ASSESSORS MAP  
1997 PHOTO

PREPARATION OF THIS MAP IS FOR THE  
PURPOSE OF IDENTIFYING THE LOCATION OF  
THE WATER RIGHT ONLY. THERE IS NO INTENT  
TO PROVIDE DIMENSIONS OR LOCATION OF  
PROPERTY OWNERSHIP LINES.

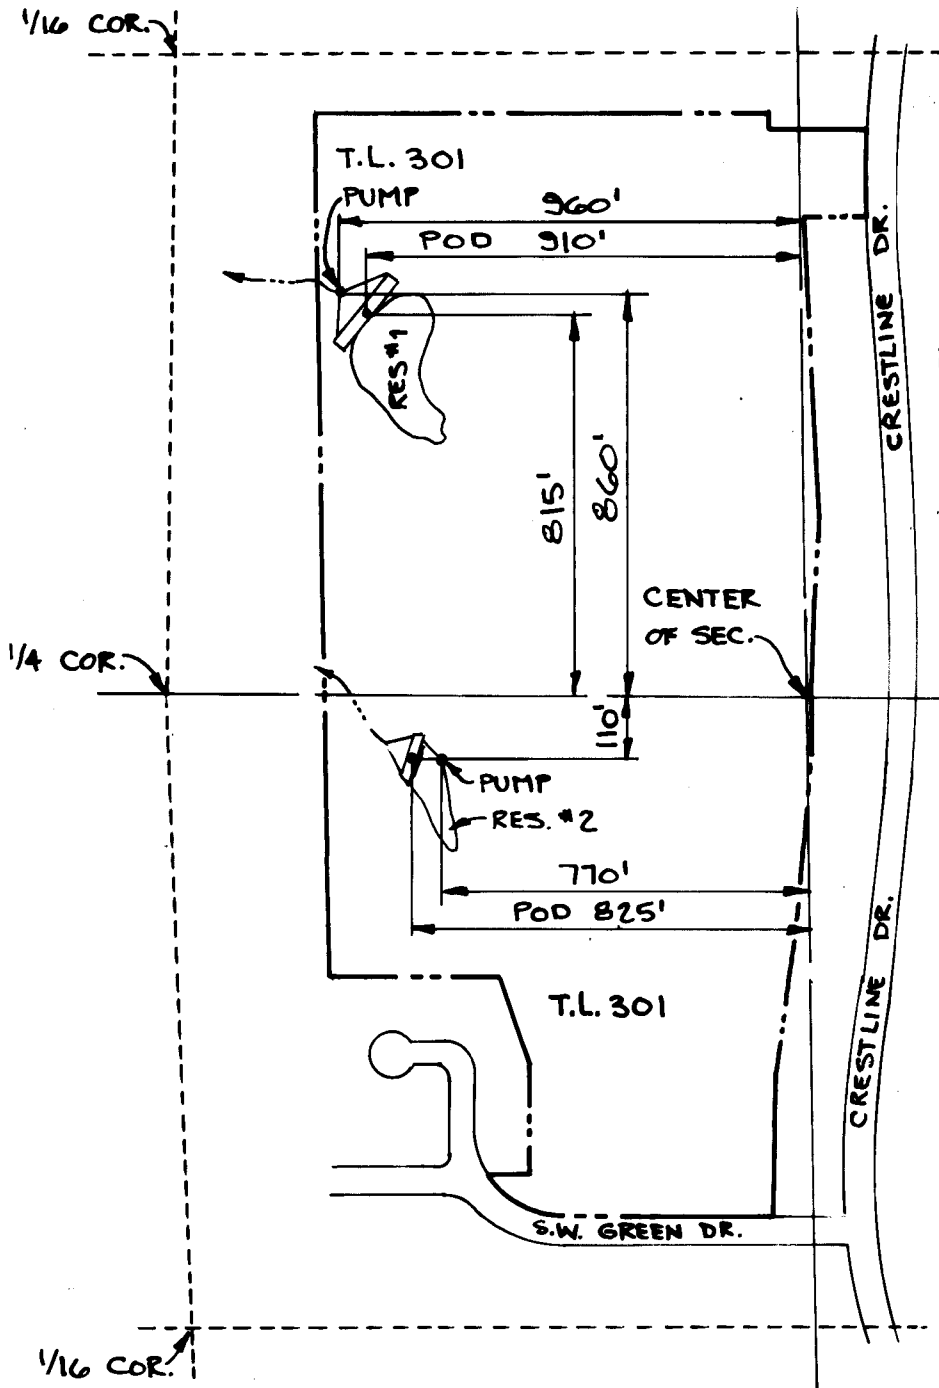

FINAL PROOF SURVEY  
SURVEYED AUGUST 7, 1998

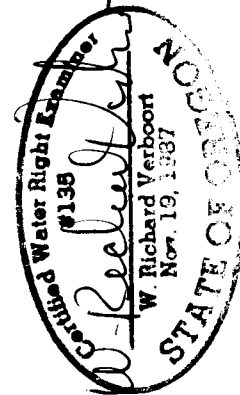

VERBOORT ENGINEERING  
AGRICULTURE • CIVIL • WATER RESOURCES  
HILLSBORO, OREGON

by date  
designed WRV 8-11-98  
drawn WRV 8-11-98  
checked WRV 8-11-98  
drawing no. 98-A-08  
sheet no. 1/1

MARK & PATRICIA CAMPBELL  
1680 S.W. CRESTLINE DR.  
WALDPORT, OR 97394