


T. 7S. R. 45E. W.M.

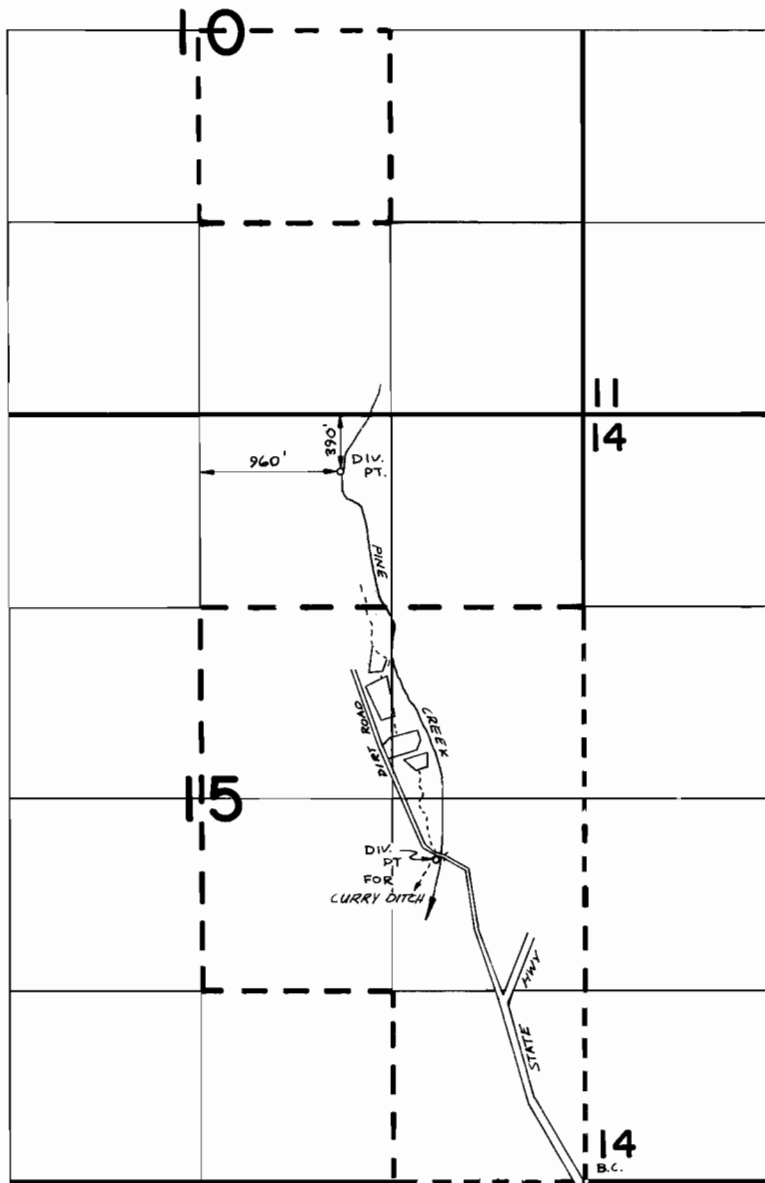

FINAL PROOF SURVEY
UNDER

Application No. **28386** Permit No. **26604**
IN NAME OF

DAVID STEINMETZ

Surveyed **5-24** 1978, by **R. BARWIN**