


SCALE 1" = 1320'

RECEIVED BY OWRD

FEB 09 2015

SALEM, OR

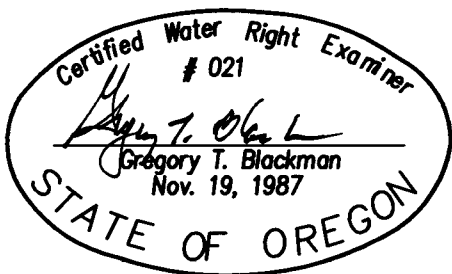

NOTE: The preparation of this map was for the purpose of identifying the location of the proposed water right and has no intent to provide dimensions or location of property ownership lines. Location information shown hereon was furnished by the applicant.

SUPERSEDING

**FINAL PROOF MAP OF
WATER RIGHTS
FOR
THOMAS E. AND JANICE I. KOHR
BY
BAGETT - GRIFFITH & BLACKMAN
2006 ADAMS AVENUE
LAGRANDE, OREGON 97850**

February 4, 2015

APPLICATION NO. G- 14071

PERMIT NUMBER G- 12530