

25 30
36 31

S.W. DELKER ROAD

NW 1/4 OF
THE NW 1/4

NE 1/4 OF
THE NW 1/4

PARCEL 4
AREA 5.0 ACRES

WELL SITE
LOCATED 1850' EAST
AND 850' SOUTH OF
THE N.W. CORNER
OF SECTION 31




WATER RIGHTS

WATER RIGHT TRAFNER FOR ROBERT FREITAS

PARCEL 4, PARTITION PLAT 1993-170
LOCATED IN THE N.W. 1/4 OF SECTION 31
TOWNSHIP 2 SOUTH, RANGE 1 EAST, W.M.
CLACKAMAS COUNTY, OREGON

SCALE 1"=200' FEBRUARY 21,2000

APPLICATION NO. T-8098
SPECIAL ORDER VOLUME 53, PAGE 684

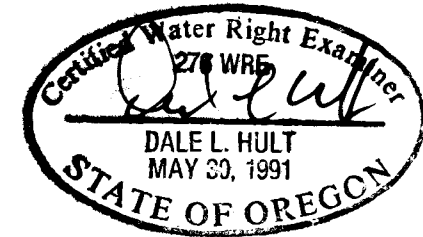

NOTE: THIS DRAWING IS NOT A LAND
SURVEY. PROPERTY LINES
AND/OR OTHER LINES OF
OCCUPATION SHOWN HEREON
ARE NOT REPRESENTED BY
THE UNDERSIGNED TO MEET
ACCURACY STANDARDS OF
LAND SURVEYS.

RECEIVED

APR 05 2000

WATER RESOURCES DEPT.
SALEM, OREGON



All COUNTY SURVEYORS
& PLANNERS, INC.
P.O. BOX 955
SANDY, OREGON 97055
(503) 668-3151

PROJECT: #97-213