


MAP

Accompanying Final Proof of Permit No. 8948 in name of Fred Witt of Rogue River Jackson Co. Oregon. for Domestic use from Spring tributary to Pleasant Creek

October 1930

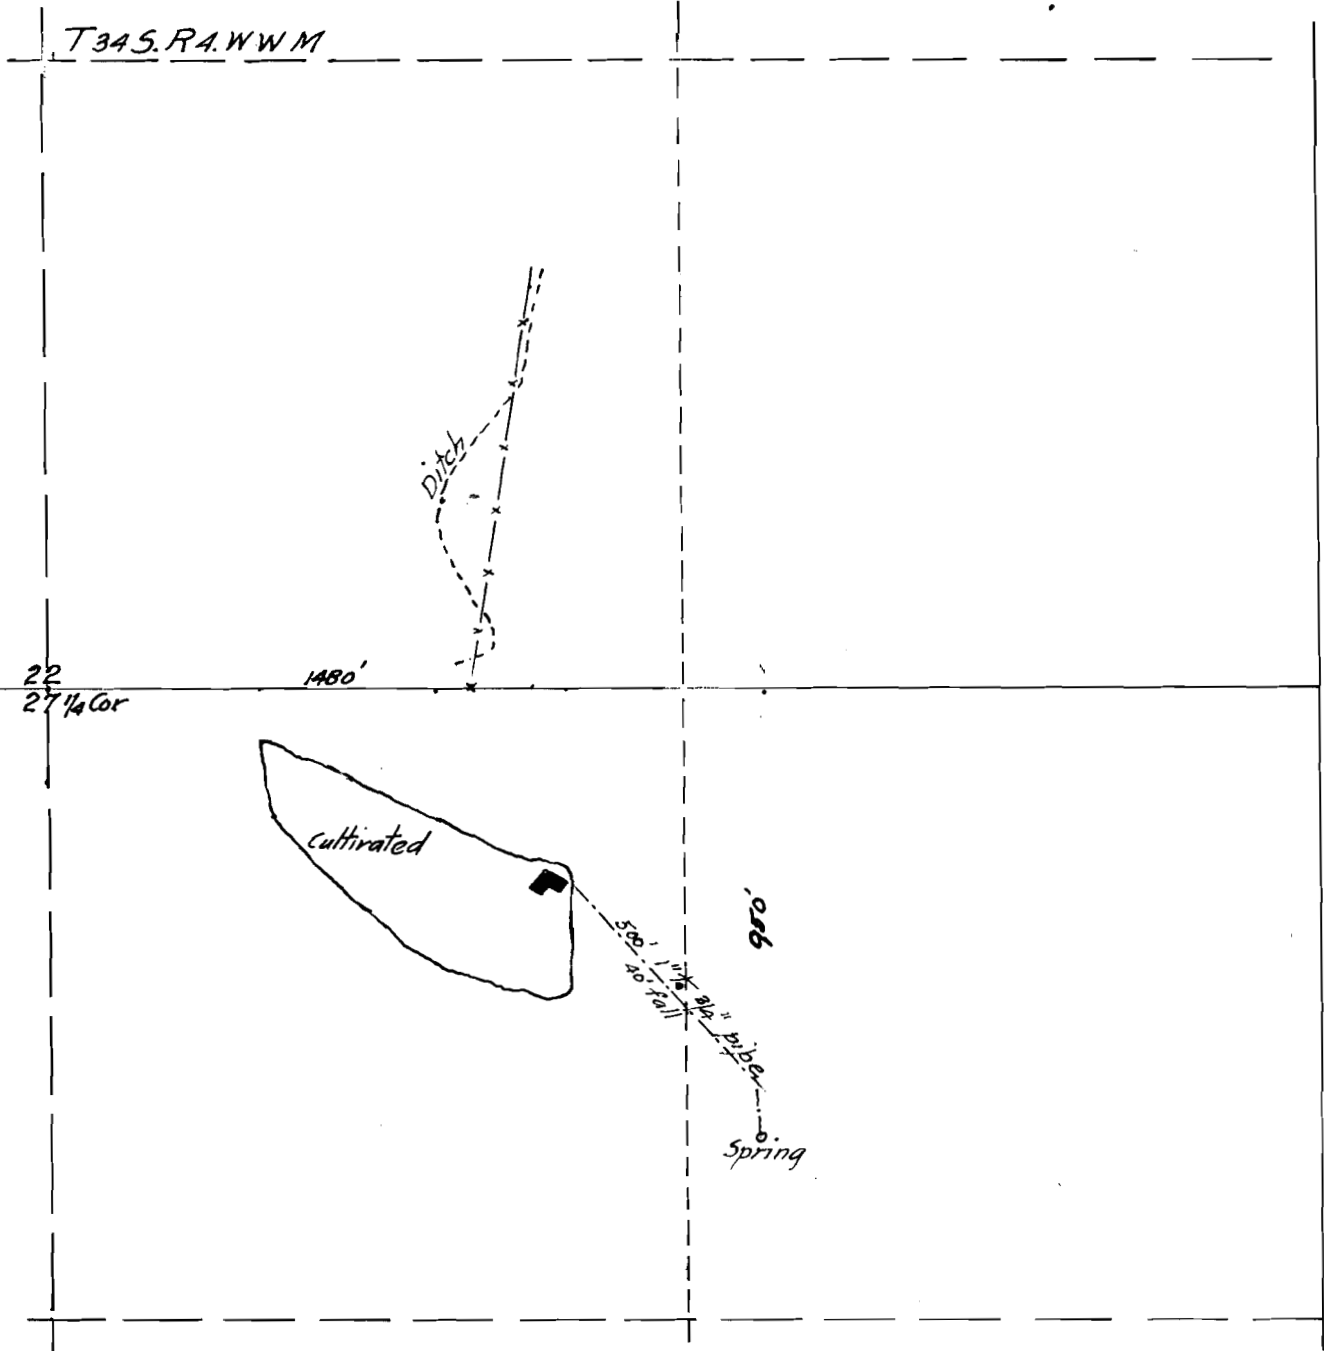

APP 12611