


RECEIVED

FEB - 8 1994

WATER RESOURCES DEPT.
SALEM, OREGON

T. 30S., R. 17E., W. M.
R. 16E

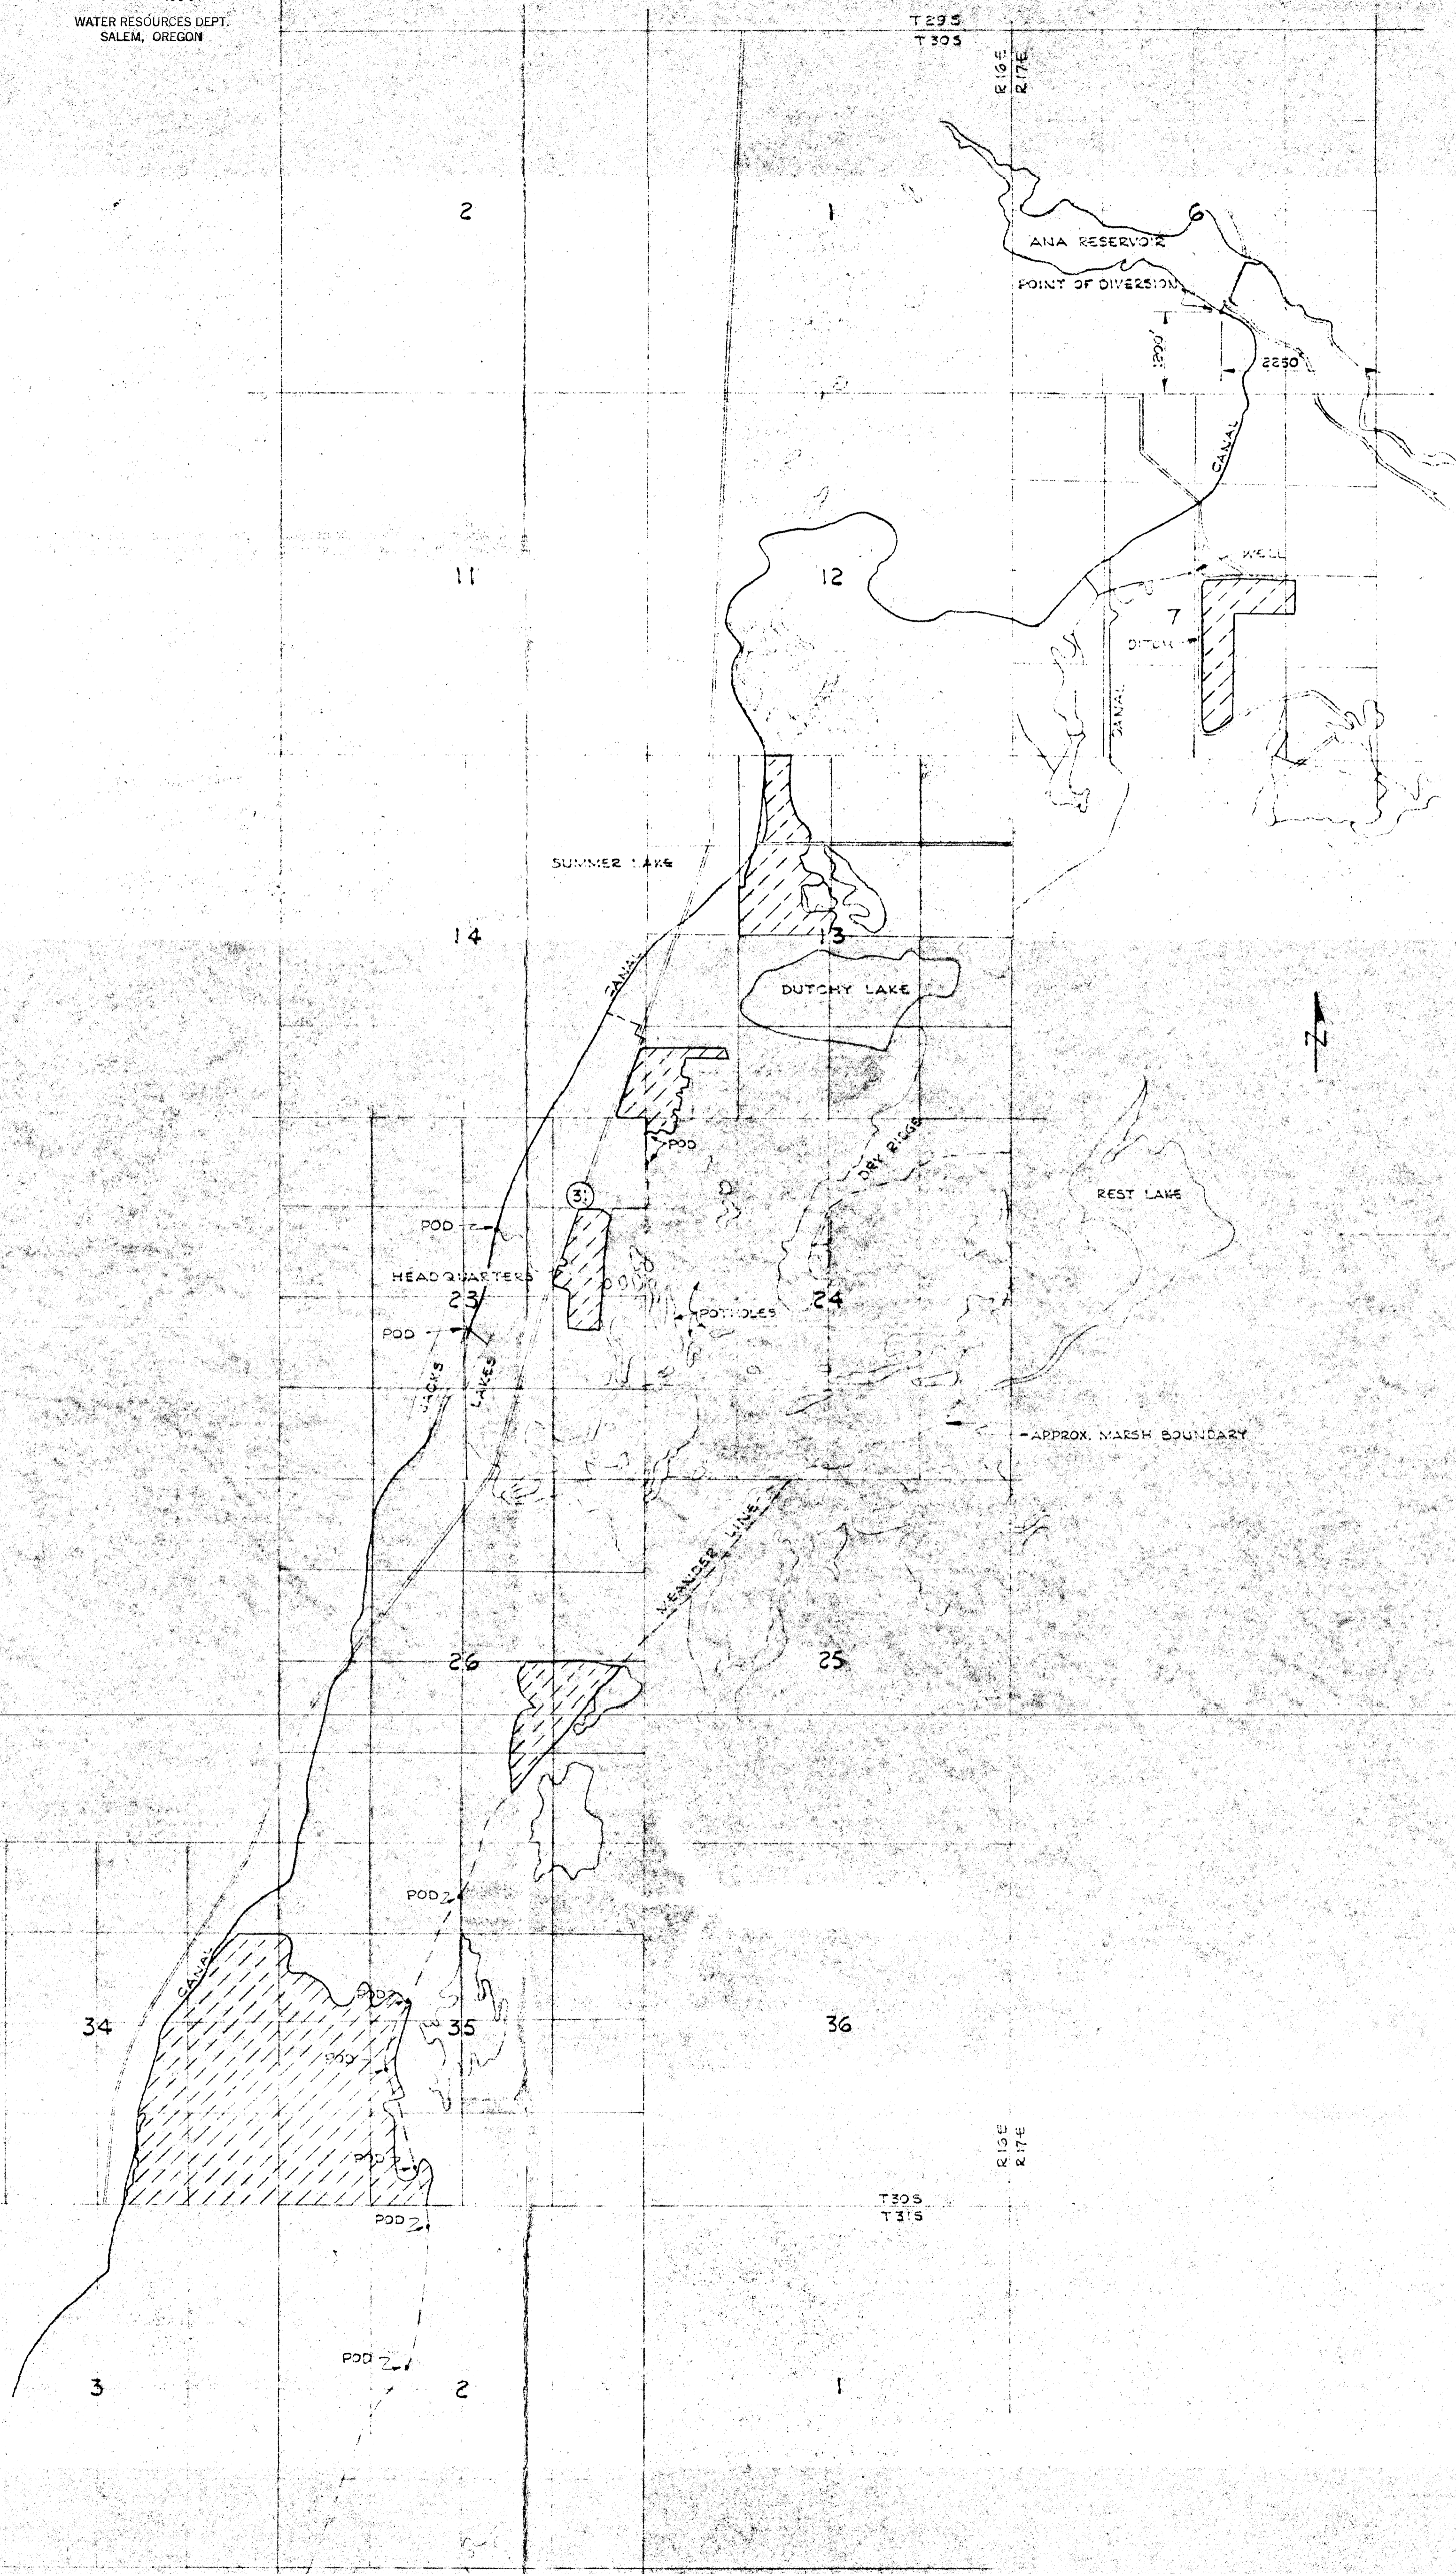

LEGEND

INDICATES AREAS WHERE WATER TO BE USED
APPLICATION NO.
PERMIT NO.

REVISIONS	
DATE	BY
AUG 5 1986	CHIEF ENGINEER
DEPARTMENT OF FISH & WILDLIFE STATE OF OREGON WATER RIGHTS MAP SUMMER LAKE W.M.A. T. 30 S., R. 17 E. LAKE COUNTY 4" = 1 MI.	
DESIGN BY	APPROVED BY
E.C.D.	DIRECTOR
CHECKED BY	
FILE NO.	SHT. 1 OF 1
8308	

RECEIVED
AUG 25 1986
WATER RESOURCES DEPT.
SALEM, OREGON

SCALE: 1"=1320'
FINAL PROOF
UNDER
T-5845
SURVEYED OCT 19 1993 BY R.M. SUTTERFIELD
IN NAME OF
OREGON DEPARTMENT OF FISH AND WILDLIFE