


RECEIVED

AUG 24 1999

WATER RESOURCES DEPT.
SALEM, OREGON

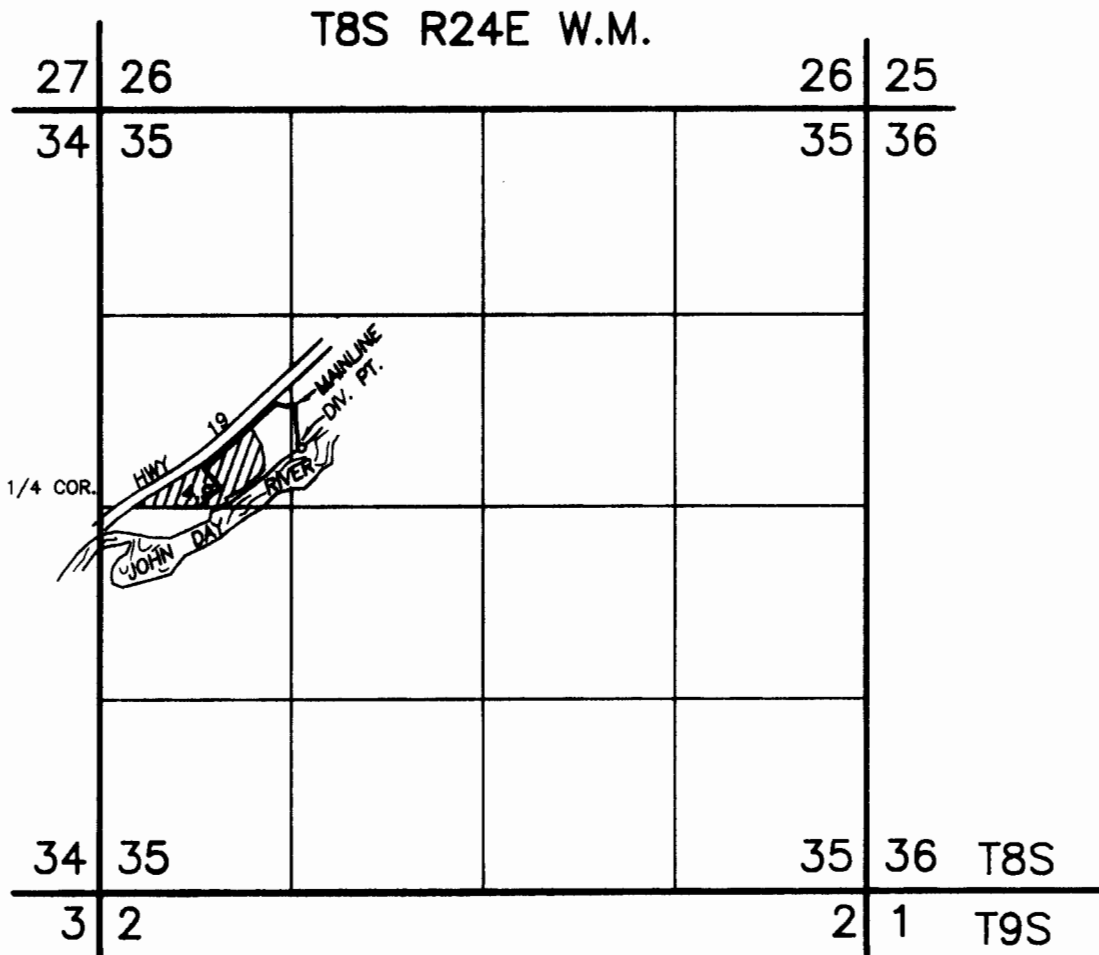

SCALE 1"=1320'

DIVERSION POINT IS 410' N. AND 1390' E. OF THE W1/4 SEC. 35

**FINAL PROOF SURVEY
UNDER**

APPLICATION 69672
PERMIT 51717

IN NAME OF
JARVIS & INGEBORG WAGNER

SURVEYED JUNE 2, 1999 BY ROBERT D. BAGETT

NOTE: The preparation of this map was for the purpose of identifying the location of the proposed water right and has no intent to provide dimensions or location of property ownership lines.

