



T. 8 S., R. 46 E., W.M.

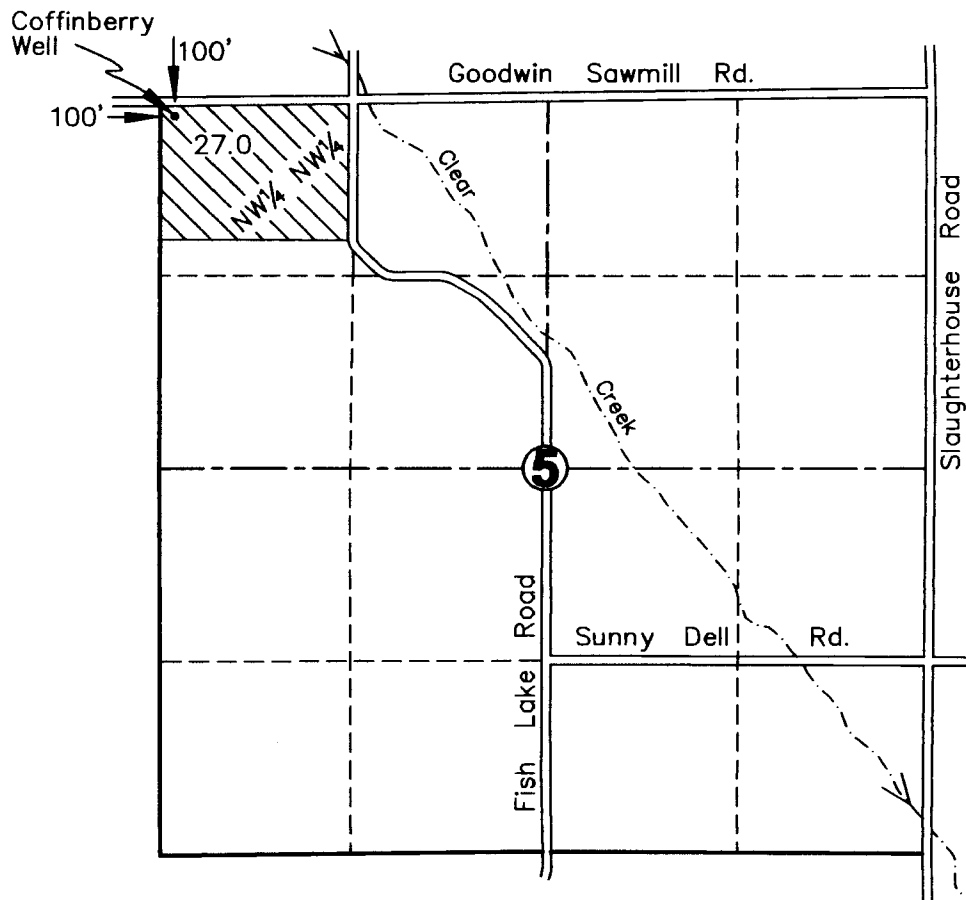

 Supplemental


Scale 1" = 1320'

FINAL PROOF SURVEY
IN NAME OF GORDON SUMMERS
Application No. G-13798
Permit No. G-13420
Site Survey Sept. 16, 2002
by Hanley Engineering

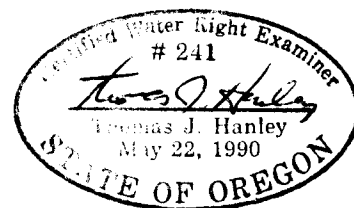

RECEIVED

SEP 30 2002

WATER RESOURCES DEPT.
SALEM, OREGON

HANLEY ENGINEERING, INC.
2043 MAIN STREET
BAKER CITY, OREGON