

SW1/4, SW1/4

SE1/4, SW1/4

13 18


24 19

FND BCIP

T. 37 S., R. 15 W.
T. 37 S., R. 14 W.

NW1/4, NW1/4

NE1/4, NW1/4

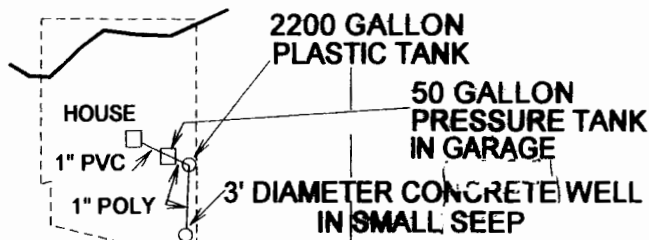

POINT OF DIVERSION
1236 FEET SOUTH
965 FEET EAST
OF NW COR., SEC. 19

SW1/4, NW1/4

SE1/4, NW1/4

THE PREPARATION OF THIS MAP WAS FOR THE PURPOSE OF IDENTIFYING
THE LOCATION OF THE PROPOSED WATER RIGHT AND HAS NO INTENT TO
PROVIDE DIMENSIONS OR LOCATION OF PROPERTY LINES.



FINAL PROOF SURVEY

NW 1/4, NW 1/4, SECTION 19
T. 37 S., R. 14 W., W. M.

SEPT. 2004

UNDER

APPLICATION S-84298

PERMIT #53723

IN THE NAME OF

CAROL HINMAN

SURVEYED SEPTEMBER 15, 2004 BY BRYAN M. FLAVIN

BRYAN FLAVIN LAND SURVEYING
BRYAN M. FLAVIN
REGISTERED LAND SURVEYOR
CERTIFIED WATER RIGHTS EXAMINER
32063 S. SUNNY VALLEY ROAD
GOLD BEACH, OREGON 97444
541-247-8485
CWRE #386

STATE OF OREGON
NATURAL RESOURCES DEPT.

RECEIVED



1" = 400'