
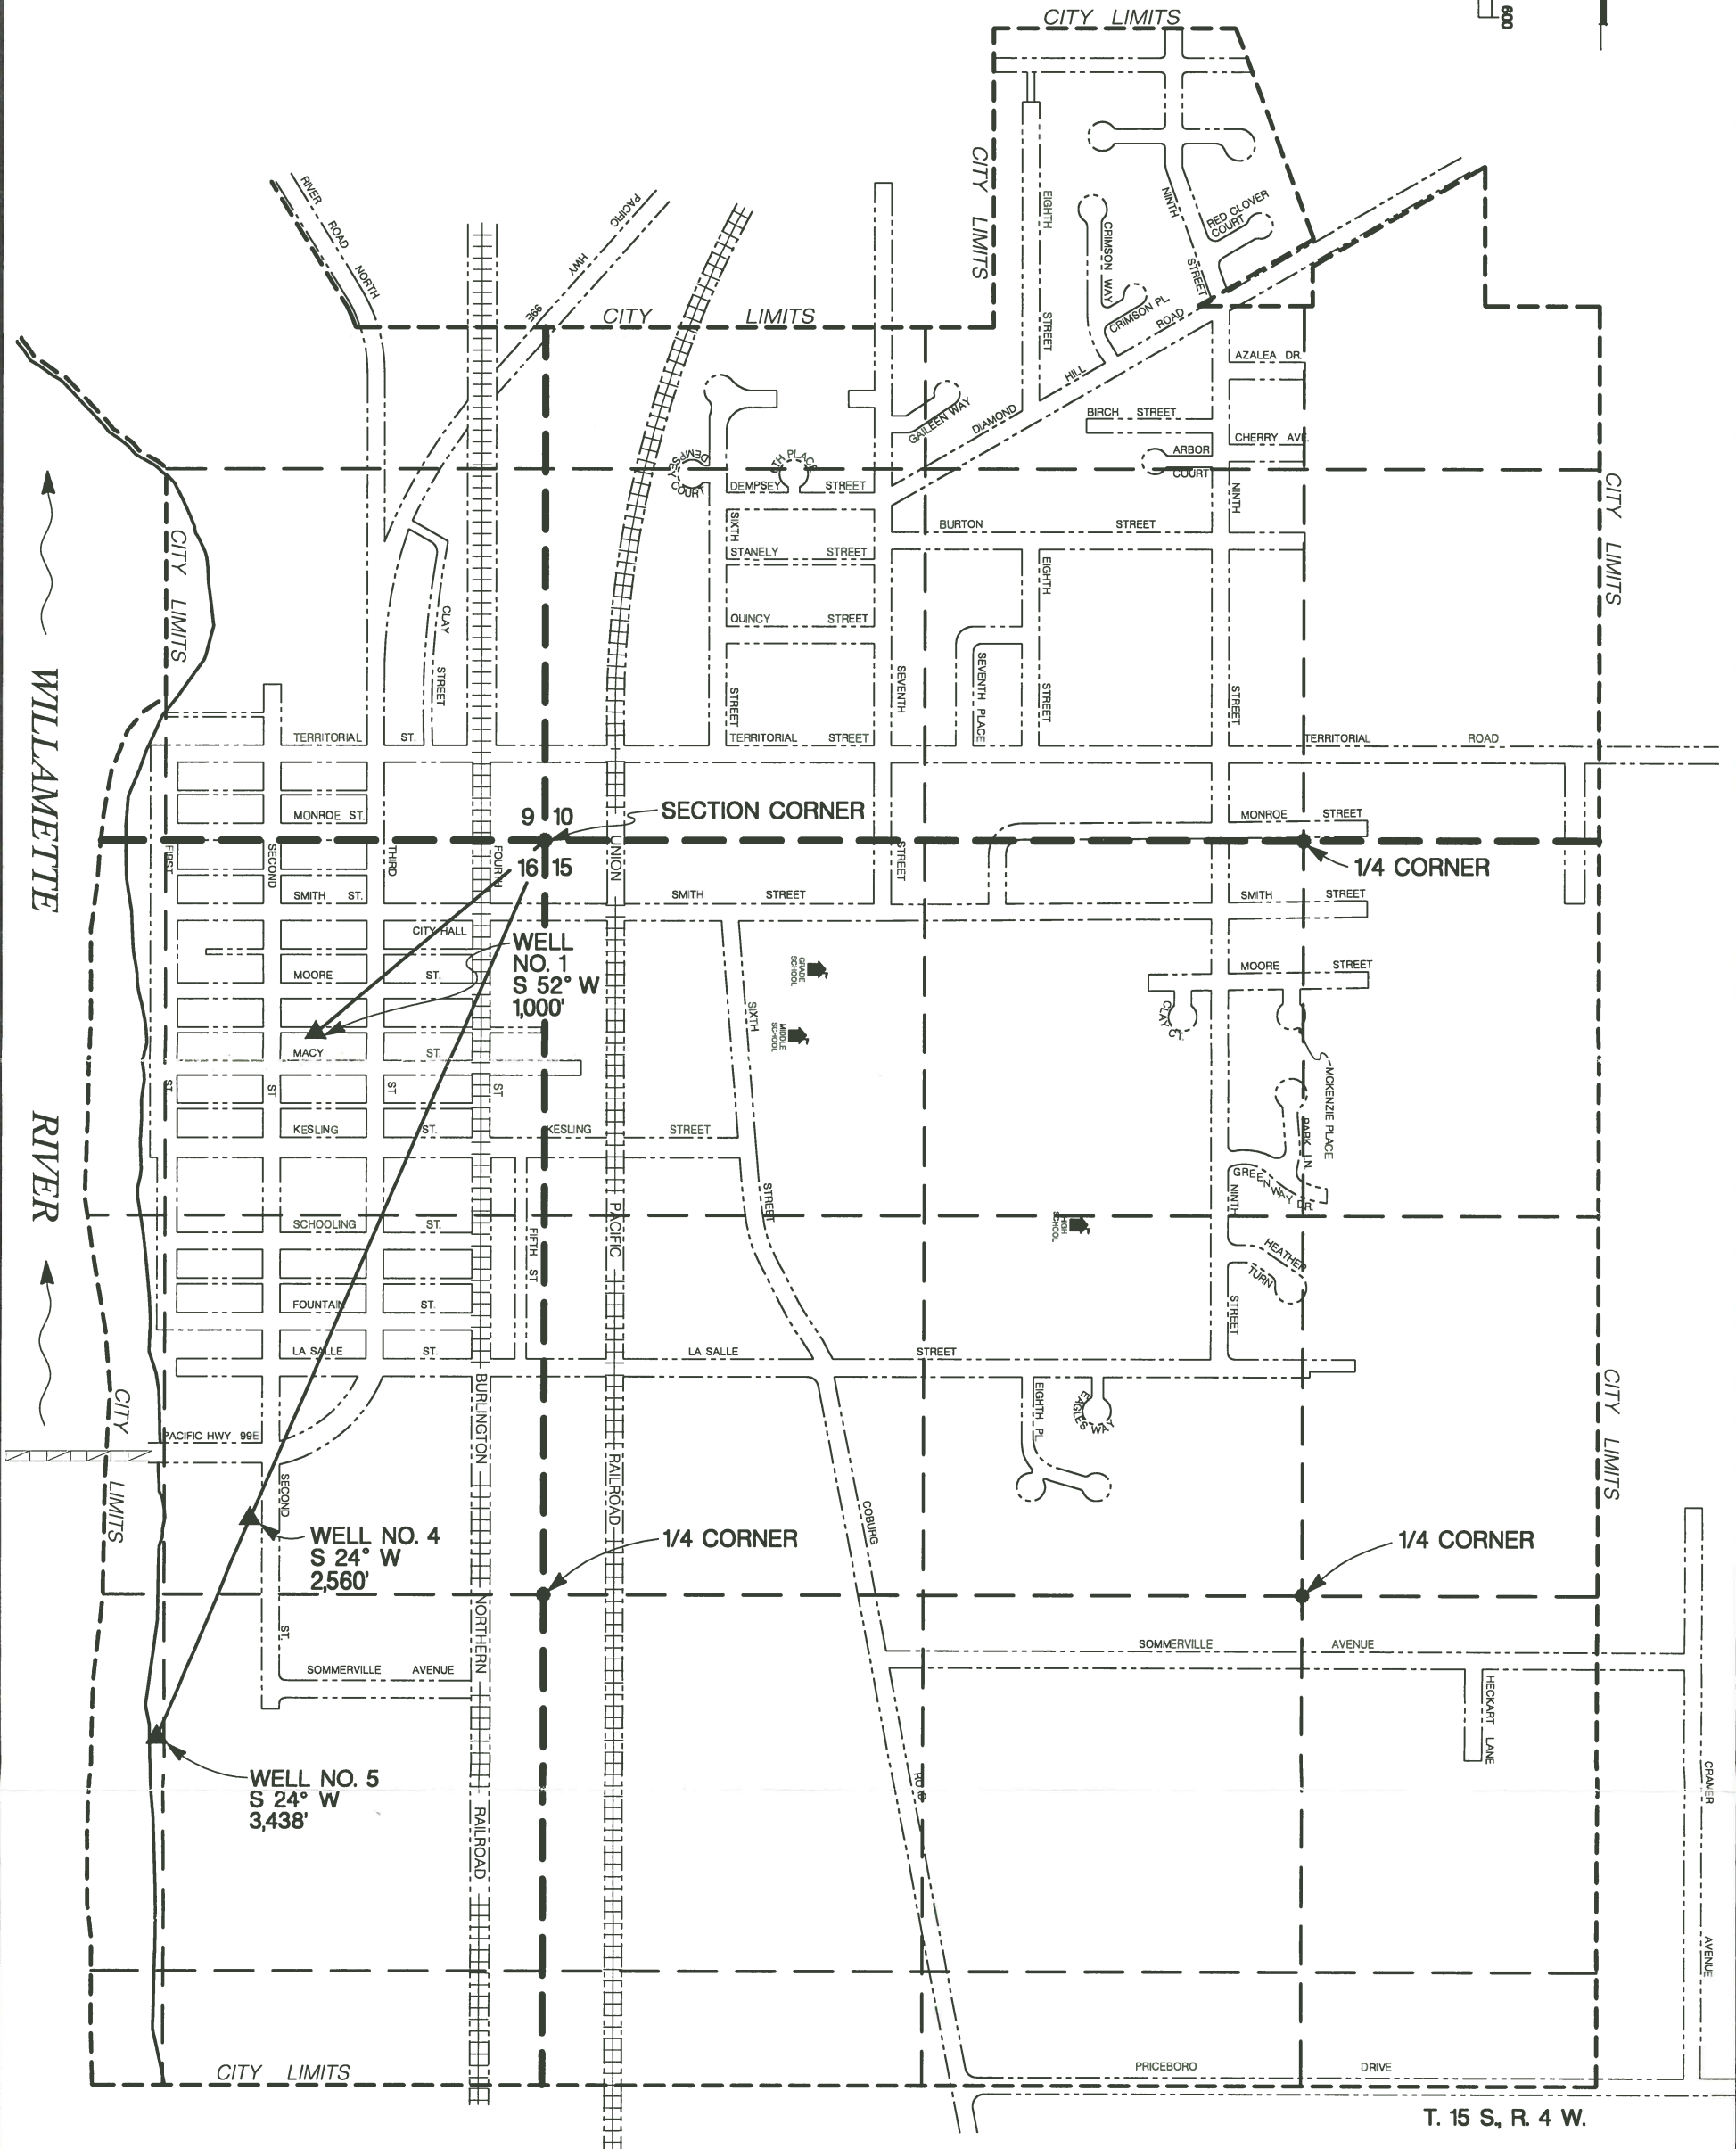


NOTES:

1. WELL NO. 1 (WATER RIGHT PERMIT NO. G-3125) HAS FAILED AND IS TO BE ABANDONED, AND ITS WATER RIGHT TRANSFERRED TO WELL NO. 5.
2. WELL NO. 4 (WATER RIGHT PERMIT NO. G-3531) IS CURRENTLY IN SERVICE.
3. WELL NO. 5 IS A NEW WELL FOR WHICH A PERMIT HAS BEEN GRANTED TO TRANSFER WATER RIGHTS FROM WELL NO. 1 (T-7867).
4. ALL WATER USE IS WITHIN THE HARRISBURG CITY LIMITS.

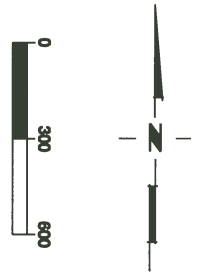

RECEIVED
 JUL 23 1999
 WATER RESOURCES DEPT
 SALEM, OREGON

WELL LOCATION MAP HARRISBURG, OREGON

REVISED : JULY 1999

