


# T.13S., R.3W., W.M. SECTION 36

**RECEIVED**

SEP 28 1998

WATER RESOURCES DEPT.  
SUNNYVALE, OREGON

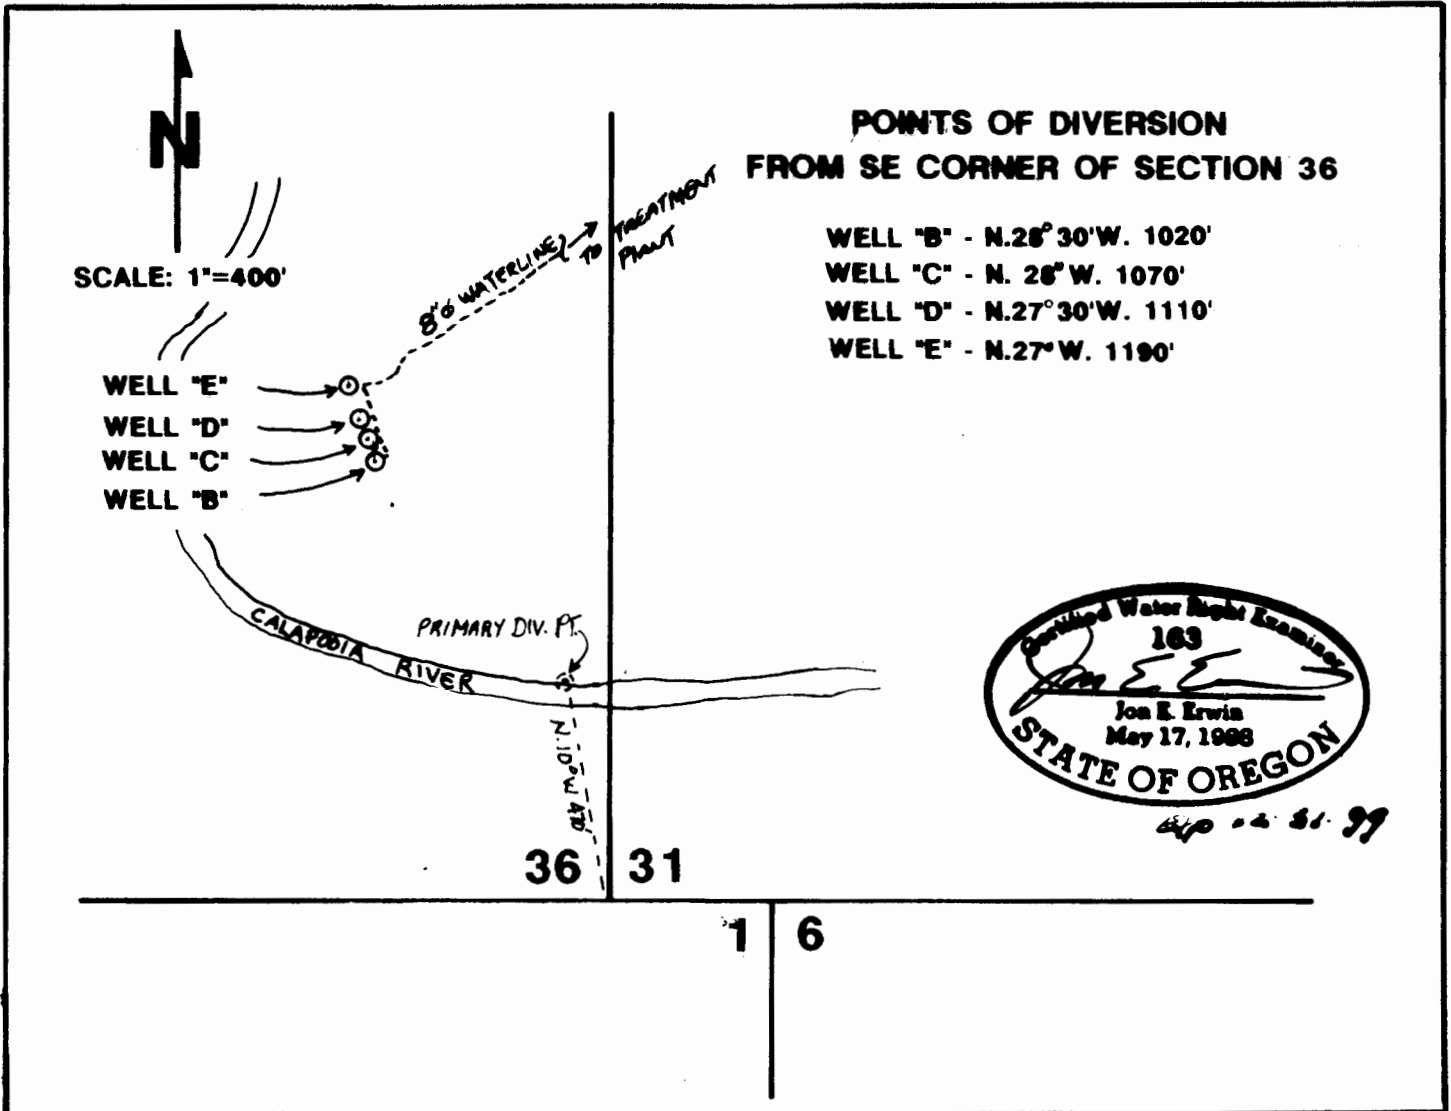

**FINAL PROOF MAP**

**PERMIT No. T6860**

**IN THE NAME OF**

**CITY OF BROWNSVILLE**

**P.O. BOX 188**

**BROWNSVILLE, OR 97327**