


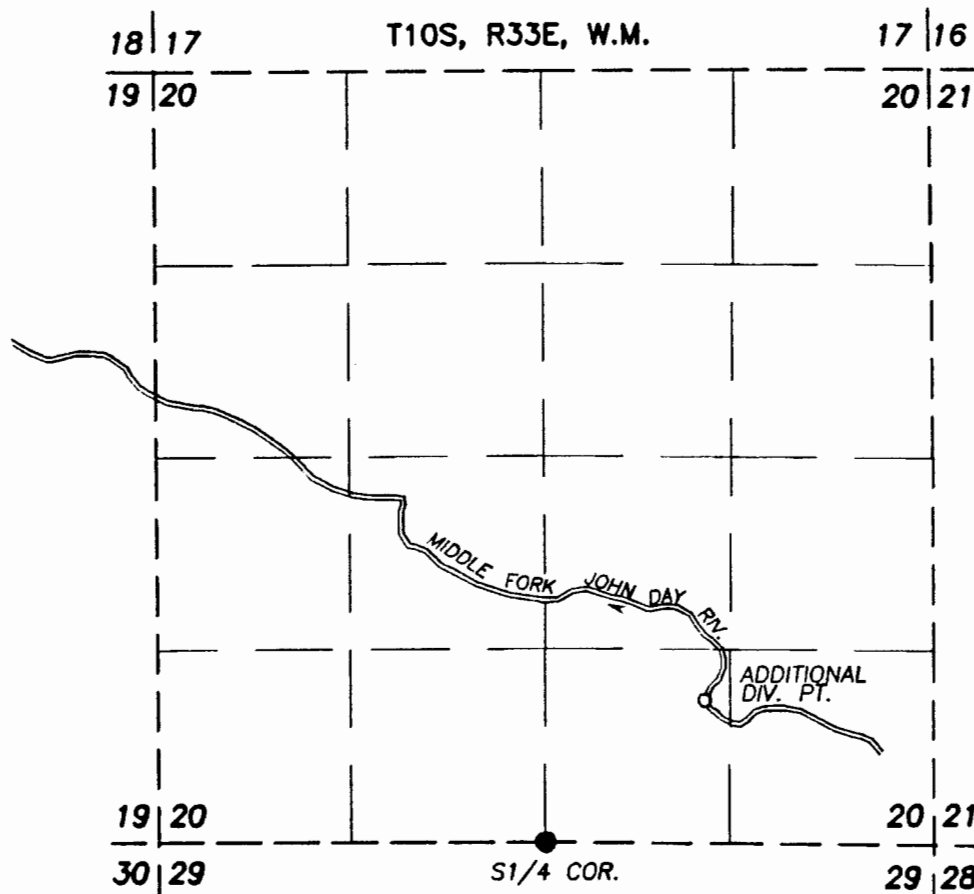

SCALE: 1" = 1320'

ADDITIONAL DIV. PT. IS 970 FT. NORTH AND 1090 FT. EAST OF S1/4 COR. OF SEC. 20.

● FOUND ALUMINUM PIPE AND CAP

FINAL PROOF SURVEY
UNDER PERMIT NO. T-8172
 IN NAME OF
LEVELLE HOLMES

SURVEYED NOVEMBER 4, 2003, BY R.D. BAGETT

NOTE: The preparation of this map was for the purpose of identifying the location of the proposed water right and has no intent to provide dimensions or location of property ownership lines.

RECEIVED

APR 21 2004

WATER RESOURCES DEPT
 SALEM, OREGON

