


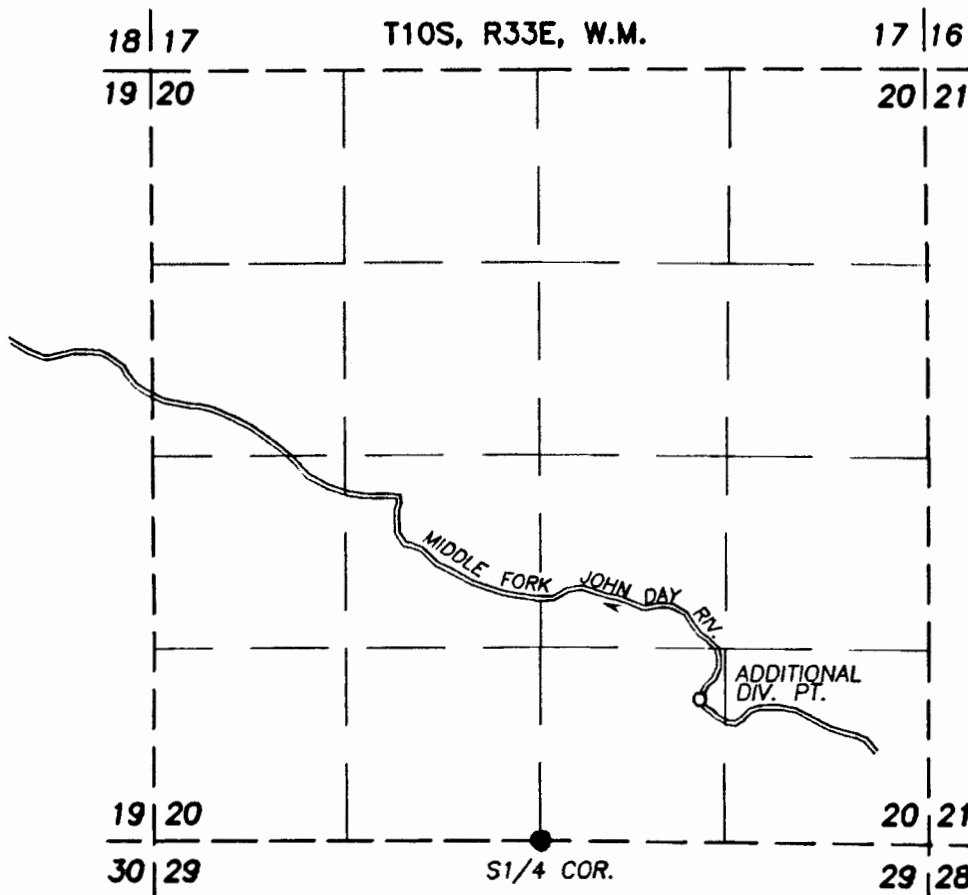

SCALE: 1" = 1320'

ADDITIONAL DIV. PT. IS 970 FT. NORTH AND 1090 FT. EAST OF S1/4 COR. OF SEC. 20.

● FOUND ALUMINUM PIPE AND CAP

**FINAL PROOF SURVEY**  
 UNDER PERMIT NO. T-8172  
 IN NAME OF  
**LEVELLE HOLMES**

**SURVEYED NOVEMBER 4, 2003, BY R.D. BAGETT**

NOTE: The preparation of this map was for the purpose of identifying the location of the proposed water right and has no intent to provide dimensions or location of property ownership lines.

**RECEIVED**

APR 21 2004

WATER RESOURCES DEPT  
 SALEM, OREGON

