



Exhibit C

RECEIVED
WILDERNESS NOV 21 1997
WATER RESOURCES DEPT.
SALEM, OREGON

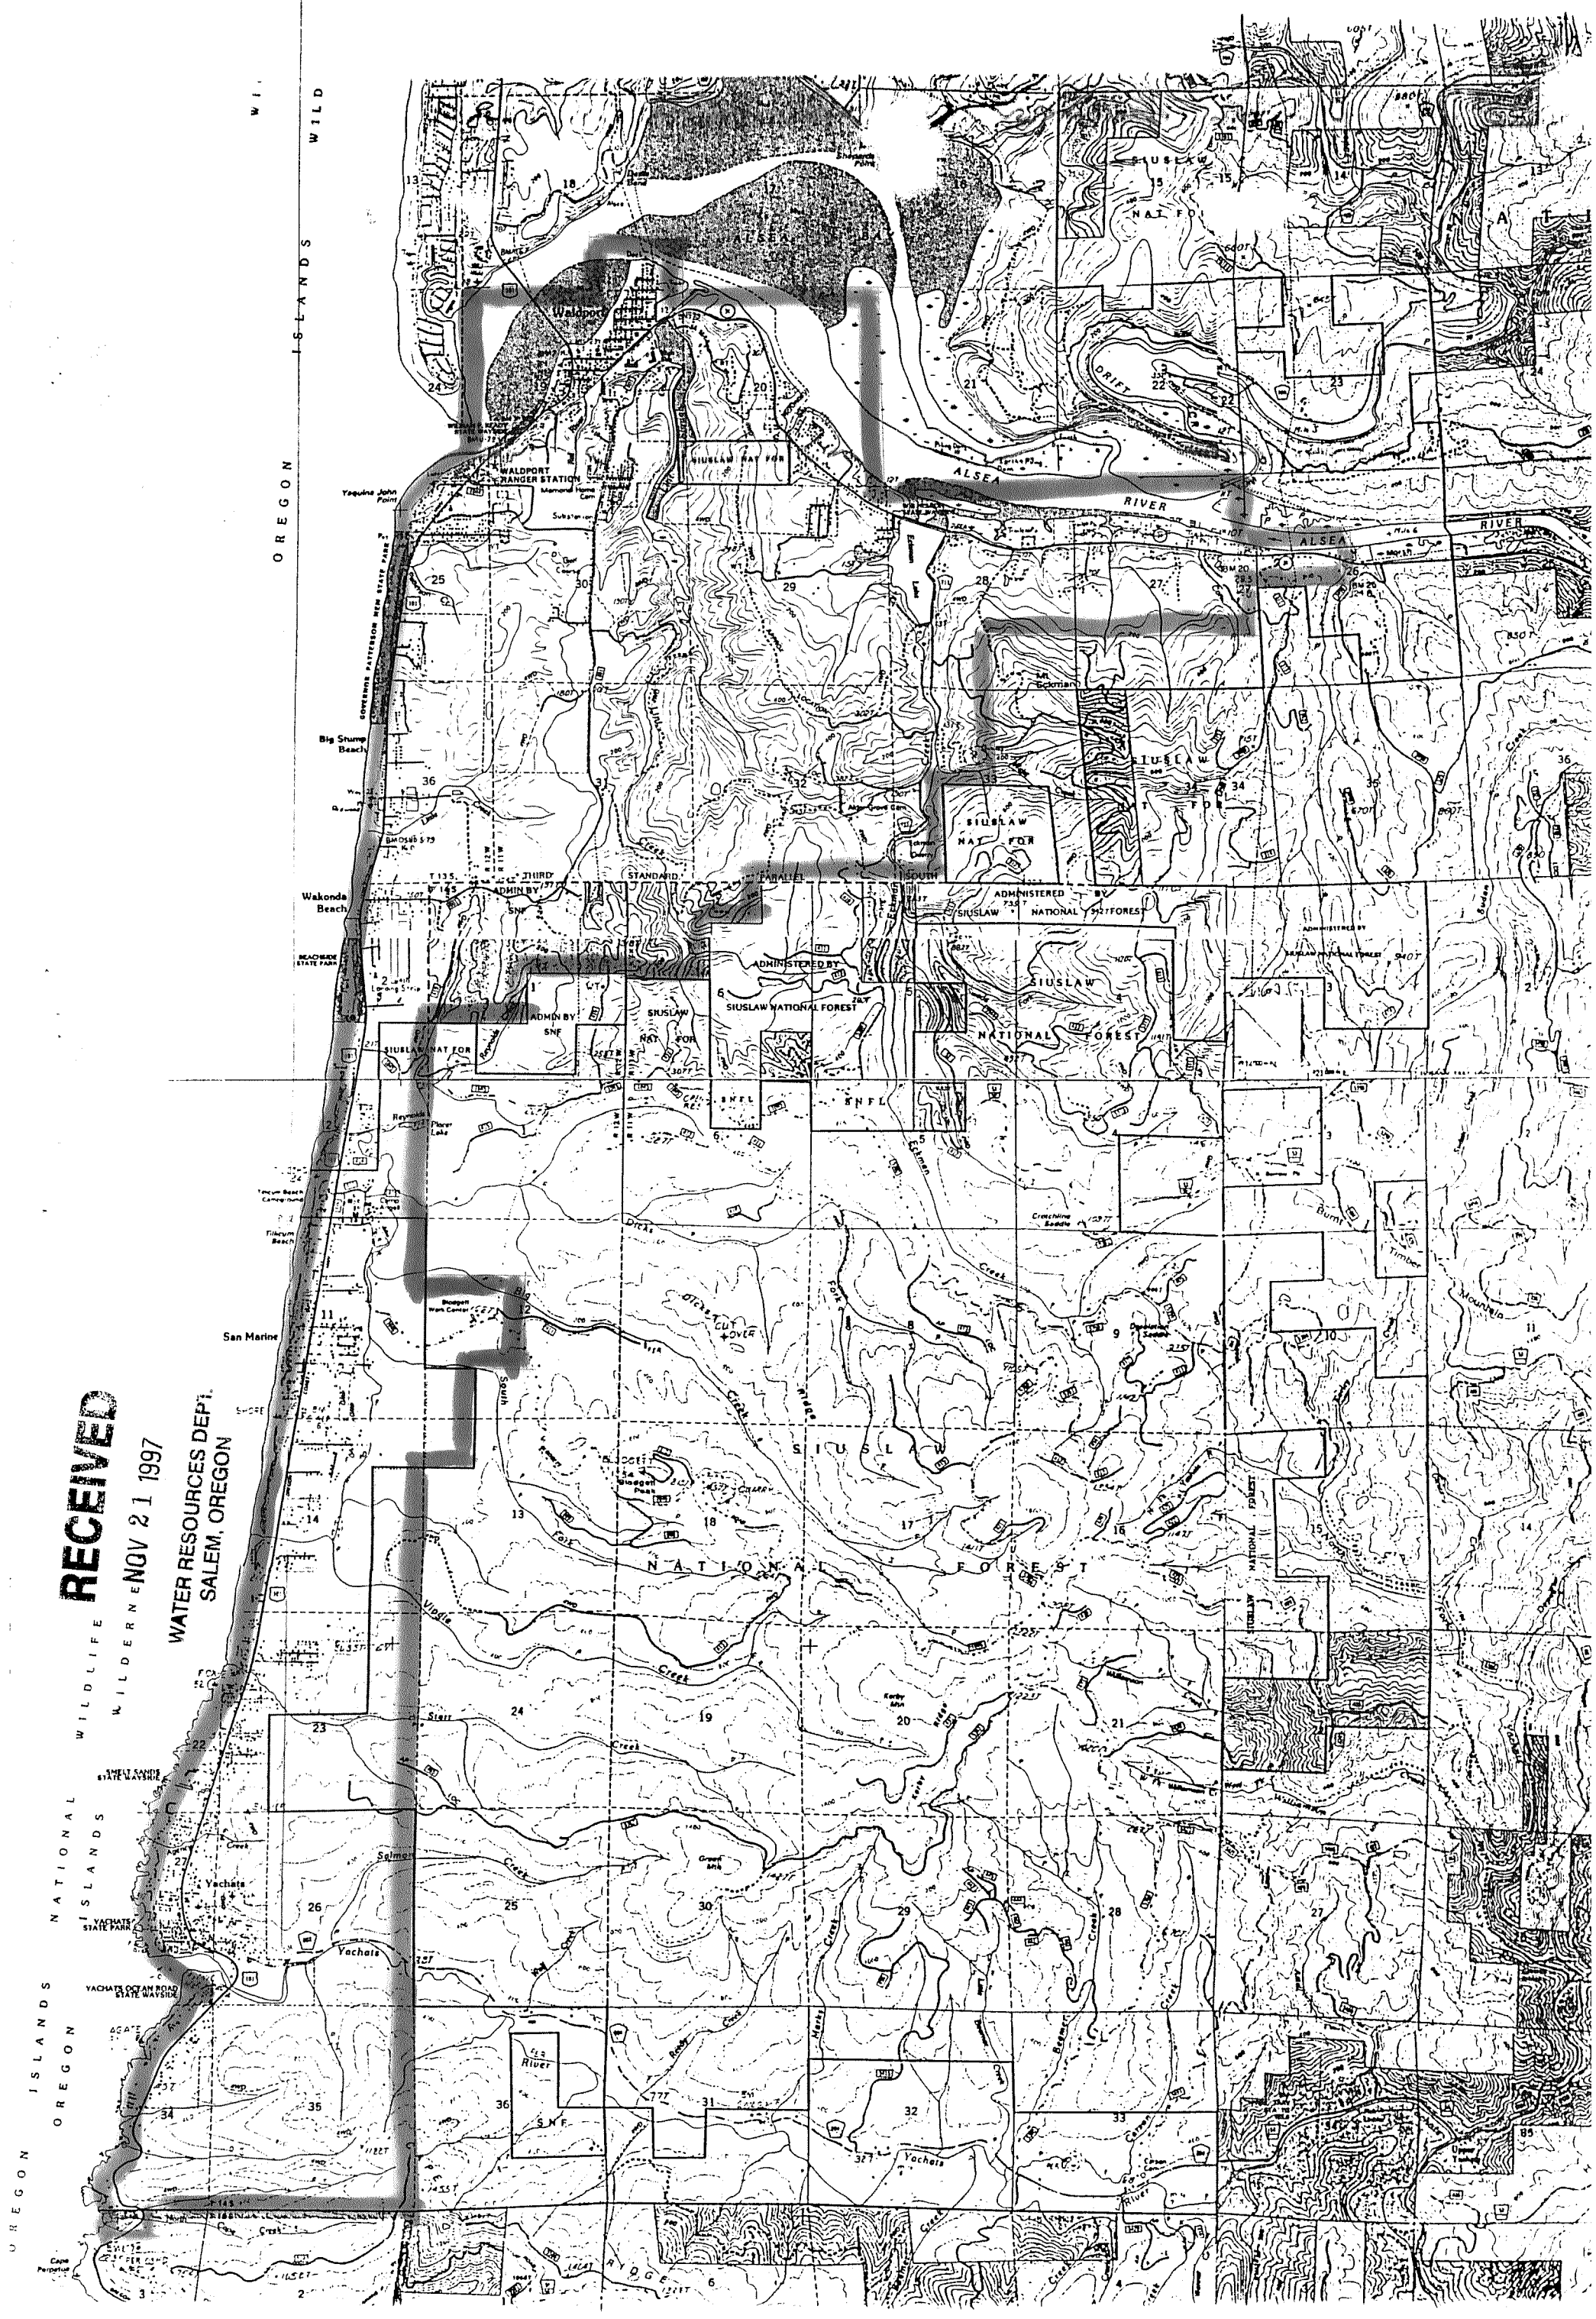

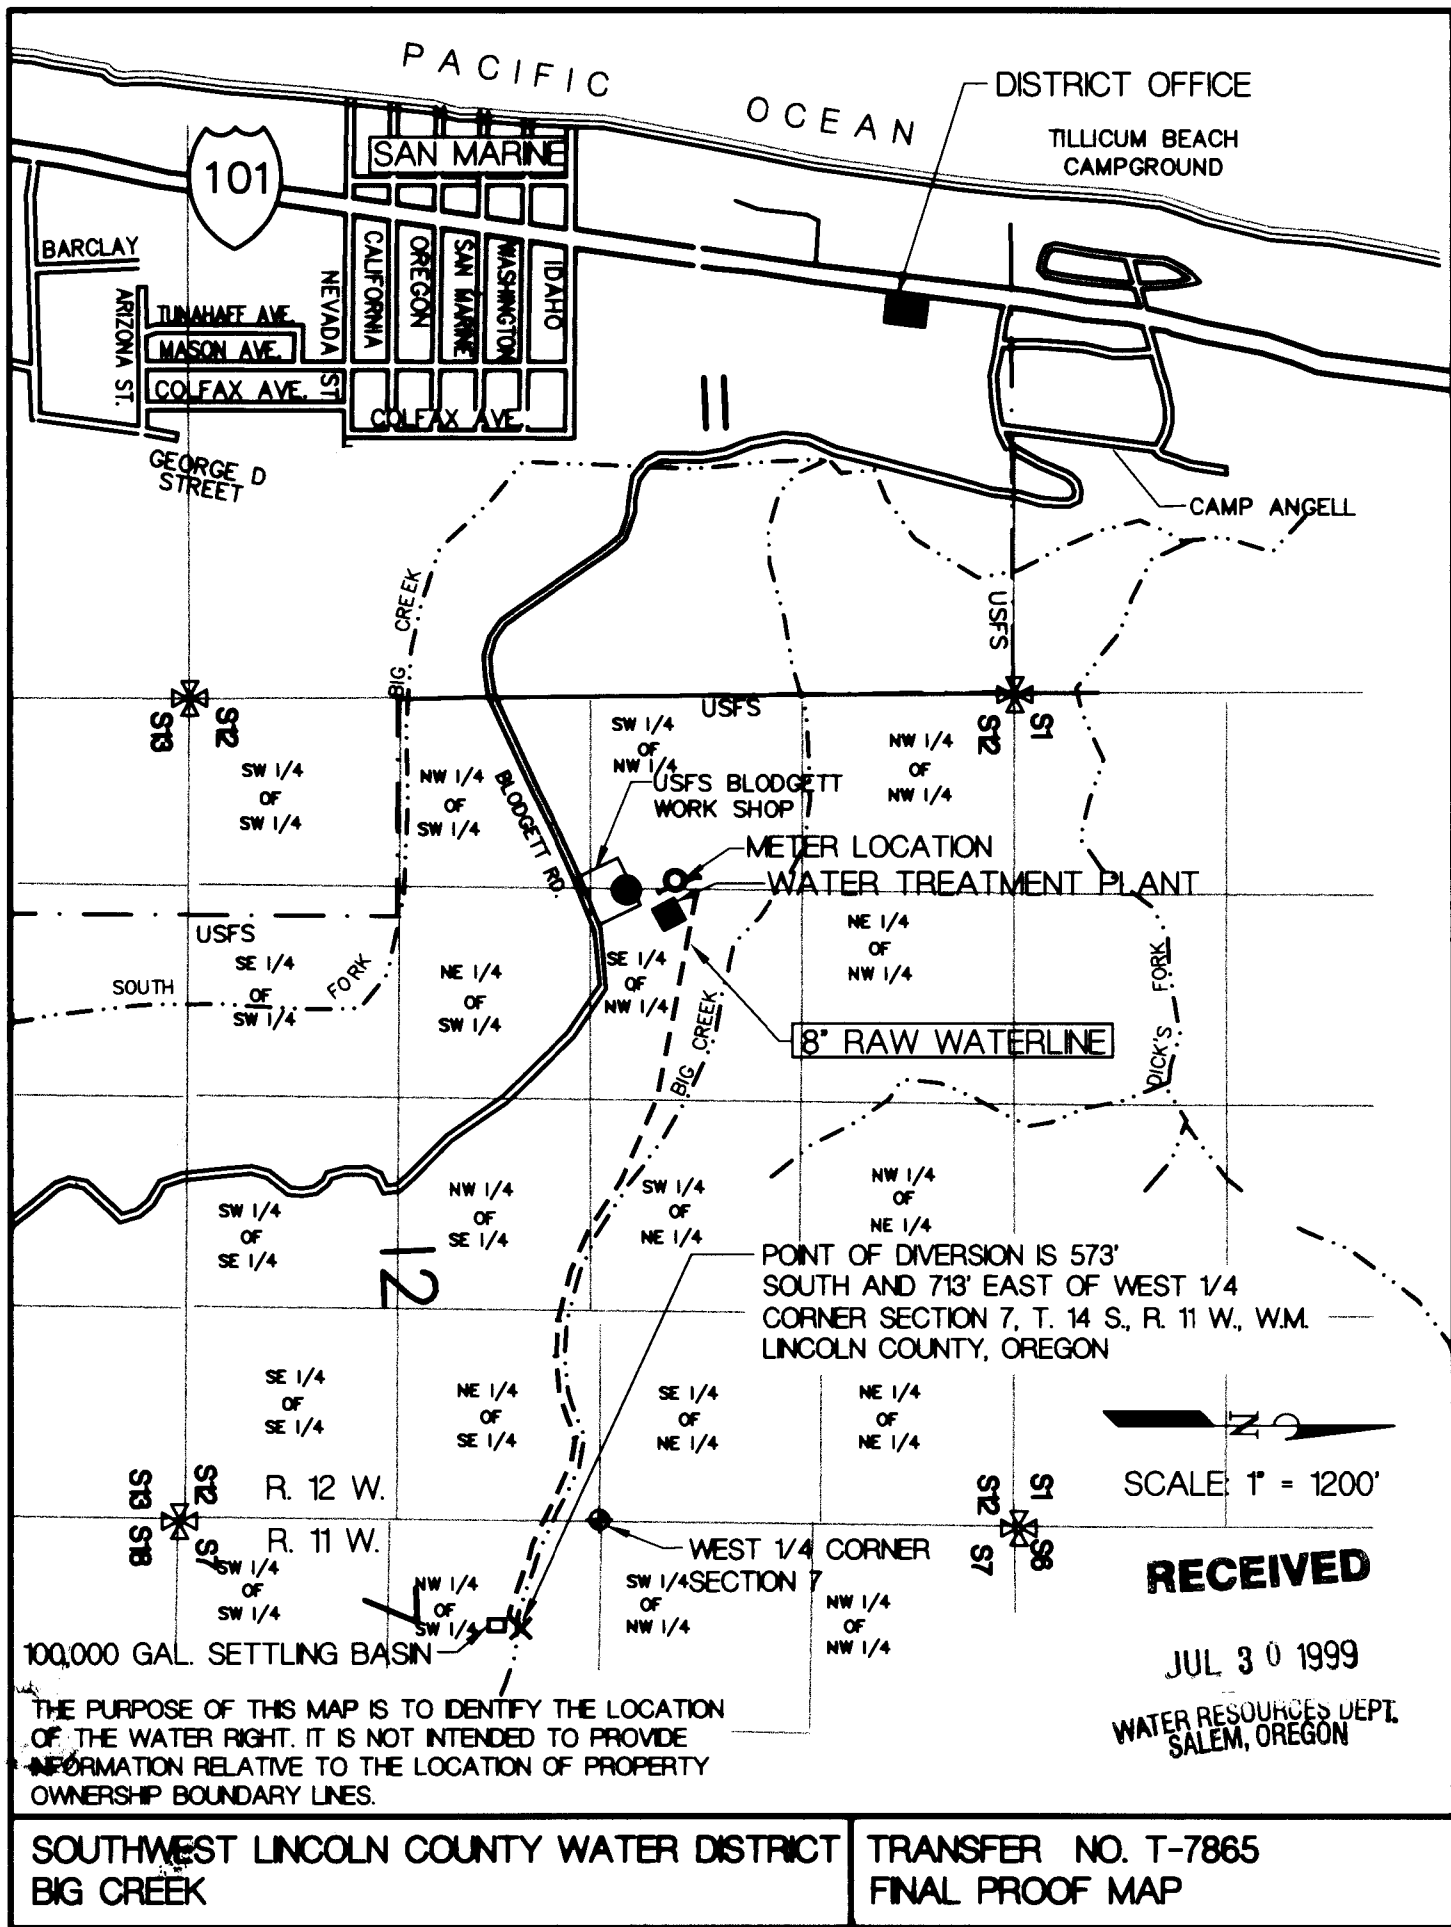

C:\LAND\PROJECTS\INACTIVE\DALE\44400\DWG\BIG-APP.DWG

THE PURPOSE OF THIS MAP IS TO IDENTIFY THE LOCATION OF THE WATER RIGHT. IT IS NOT INTENDED TO PROVIDE INFORMATION RELATIVE TO THE LOCATION OF PROPERTY OWNERSHIP BOUNDARY LINES.

**SOUTHWEST LINCOLN COUNTY WATER DISTRICT
BIG CREEK**

**TRANSFER NO. T-7865
FINAL PROOF MAP**

RECEIVED
JUL 30 1999
WATER RESOURCES DEPT.
SALEM, OREGON