


T. 1 N. R. 4 W. W. M.

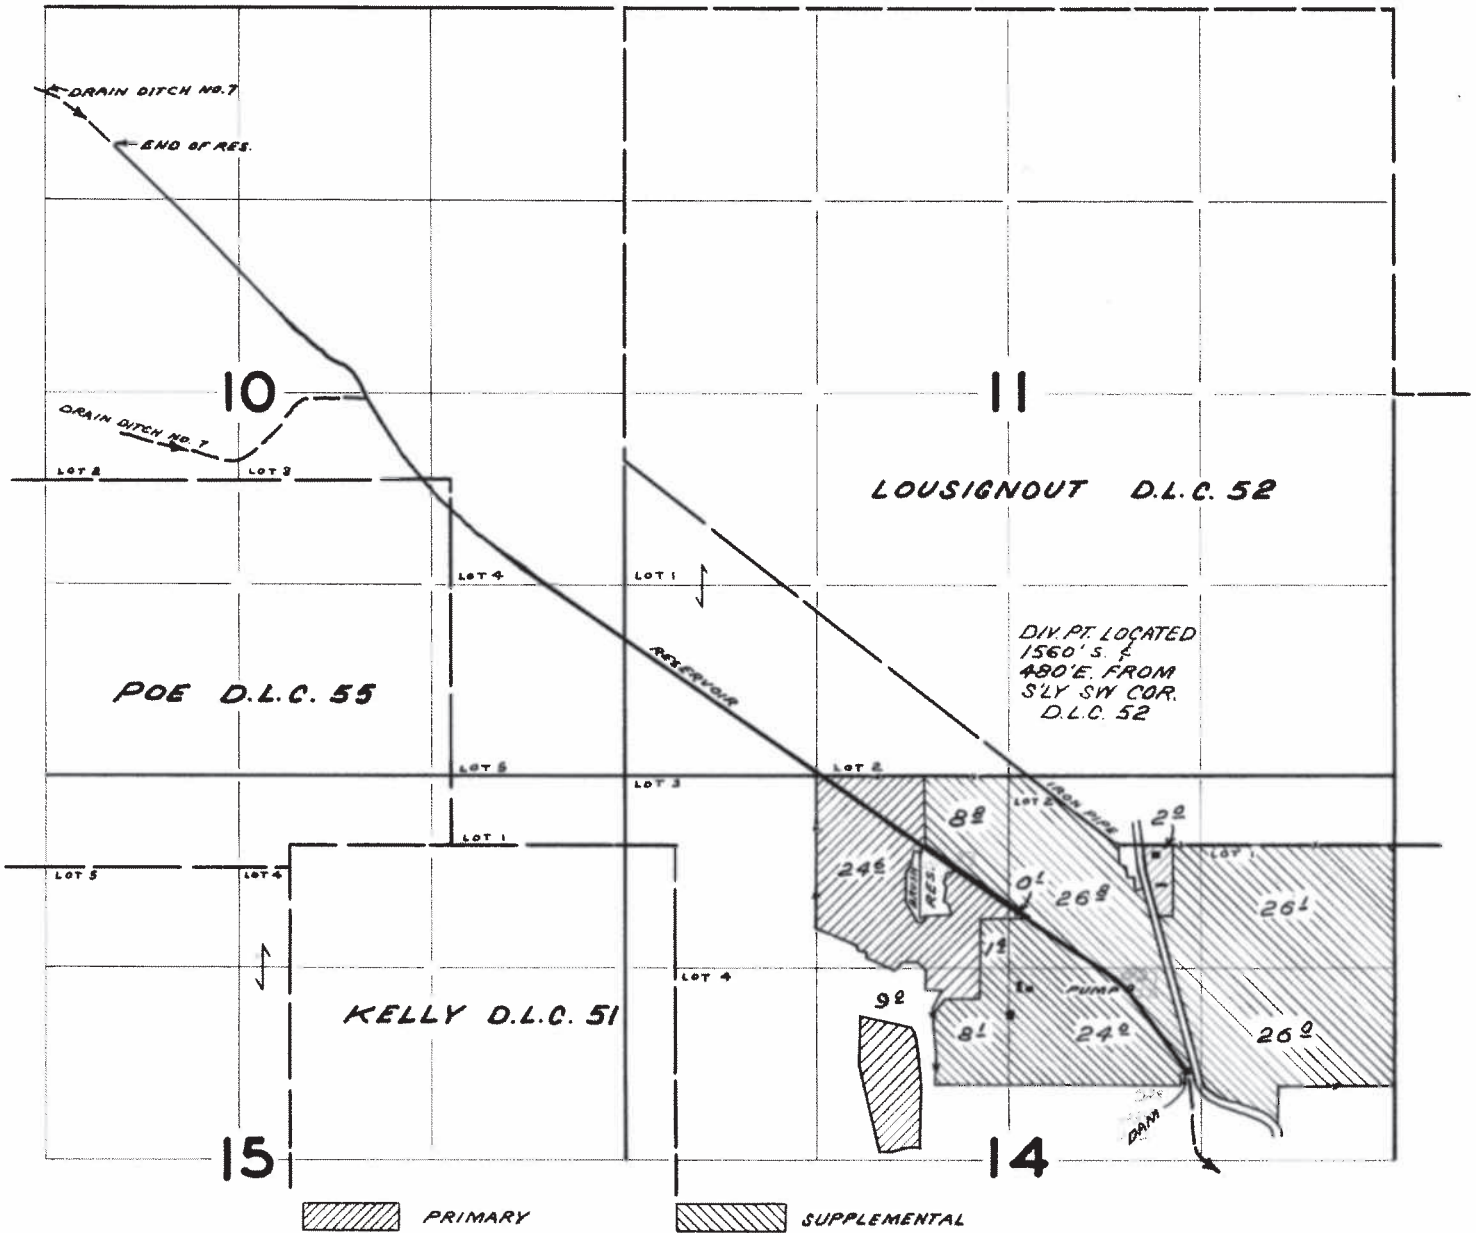

FINAL PROOF SURVEY UNDER

Application No. R-38709 38710 Permit No. R-3264 28825

IN NAME OF

MELVIN L. LOVE

Surveyed JUN 6 1967, by V. GARNER