


# T.5S.R.5W.W.M.

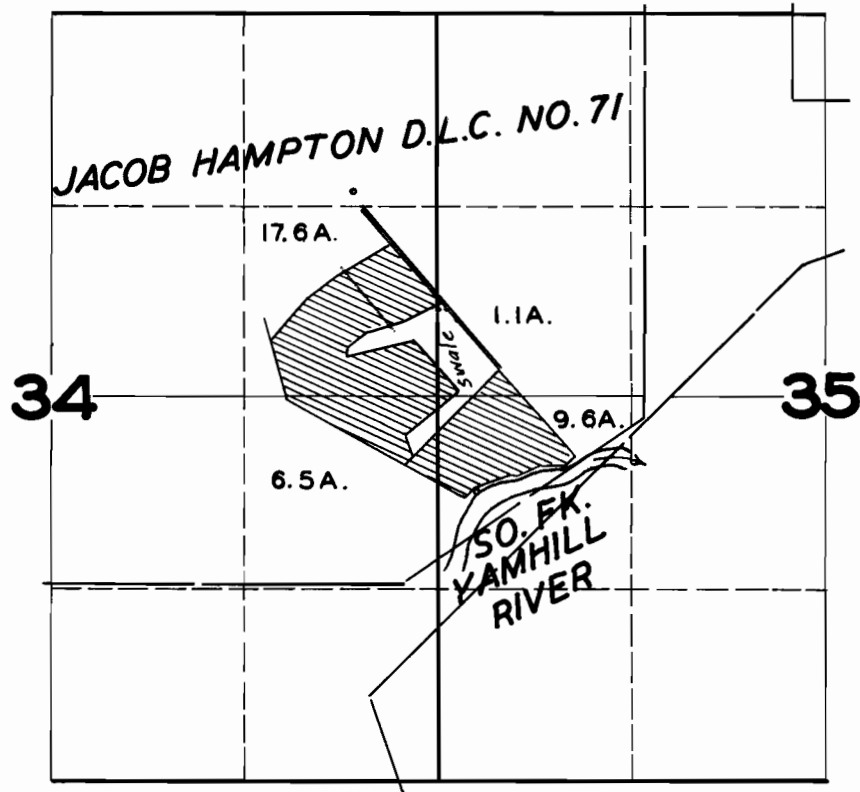

## FINAL PROOF SURVEY UNDER

Application No. **20222** Permit No. **15807**  
IN NAME OF

**MERL C. BROWN**

Surveyed **JUNE 9, 1948**, by **JAS. E. BUNNELL**