


T.5S.R.5W.W.M.

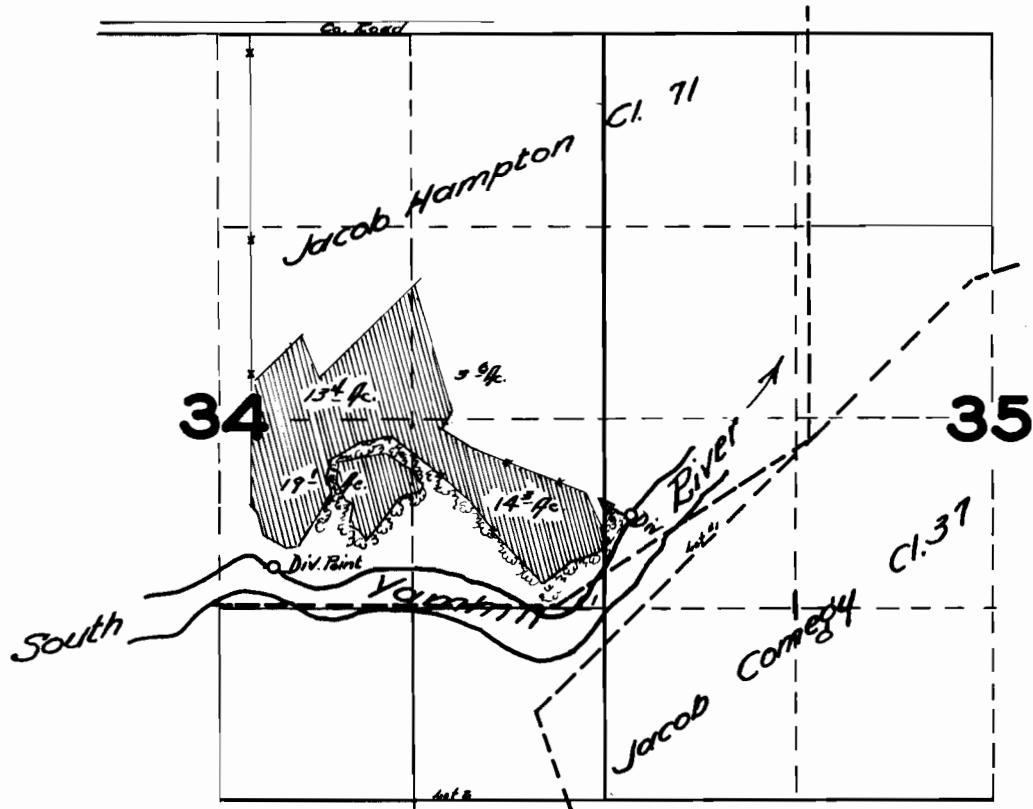

FINAL PROOF SURVEY

UNDER

Application No. 22456 Permit No. 17684
IN NAME OF

HARRY CROWE

Surveyed 9/28 1951, by H.L. COFFMAN