


T.5S., R.5W., W.M.

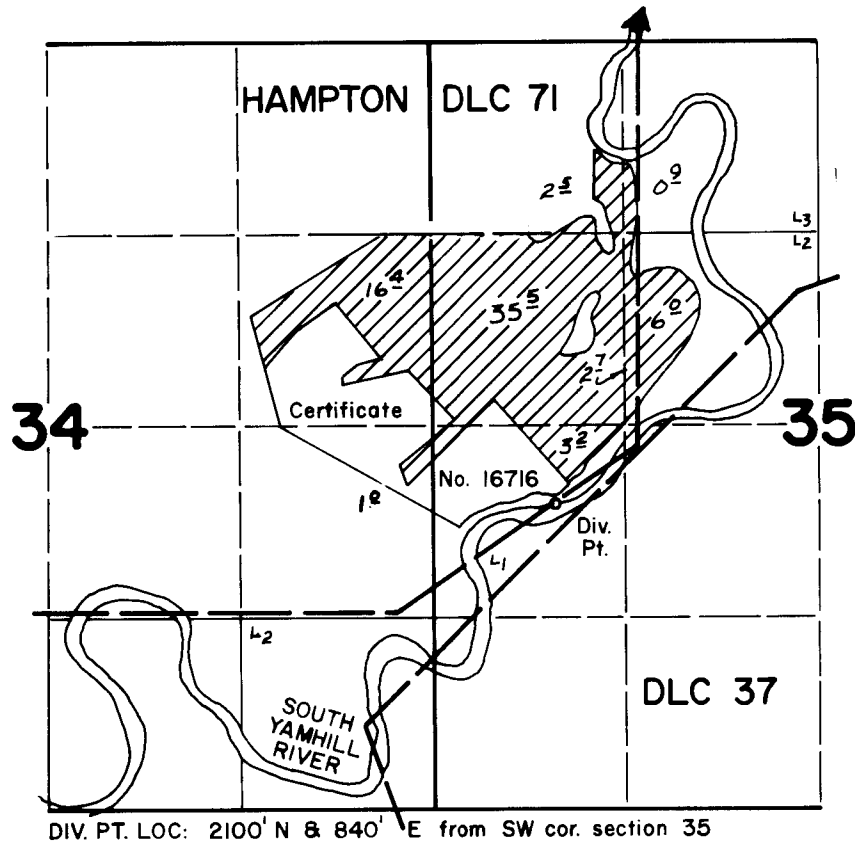

DIV. PT. LOC: 2100' N & 840' E from SW cor. section 35

**FINAL PROOF SURVEY**  
UNDER

Application No. 51910 Permit No. 39059  
IN NAME OF

CRIMSON WEST FARM INC.

Surveyed July 8 1976, by L.H. Nunn