



T. 5S., R. 5W., W.M.

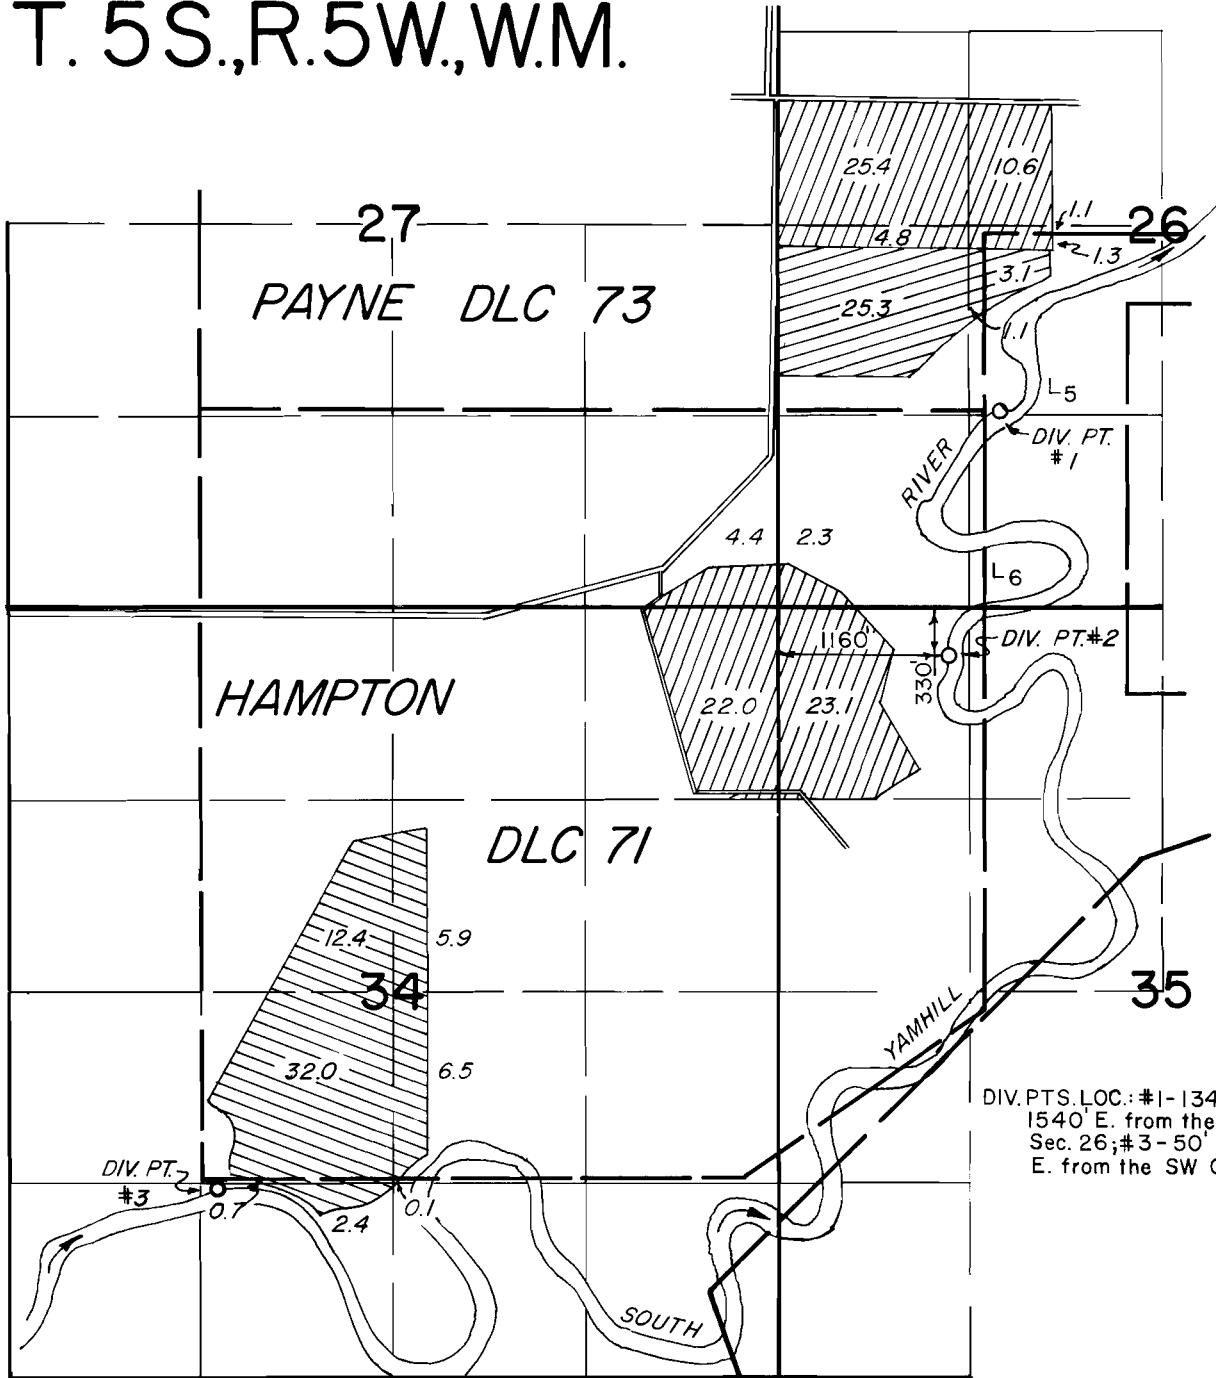

FINAL PROOF SURVEY

UNDER

54471 40859
 54472 40860
 Application No. 55832 Permit No. 42508

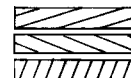

IN NAME OF

CRIMSON WEST FARMS

Surveyed JULY 20, 1977, by *J. Brown*
 MAY 31, 1979