


T.5S., R.5W., W.M. 27

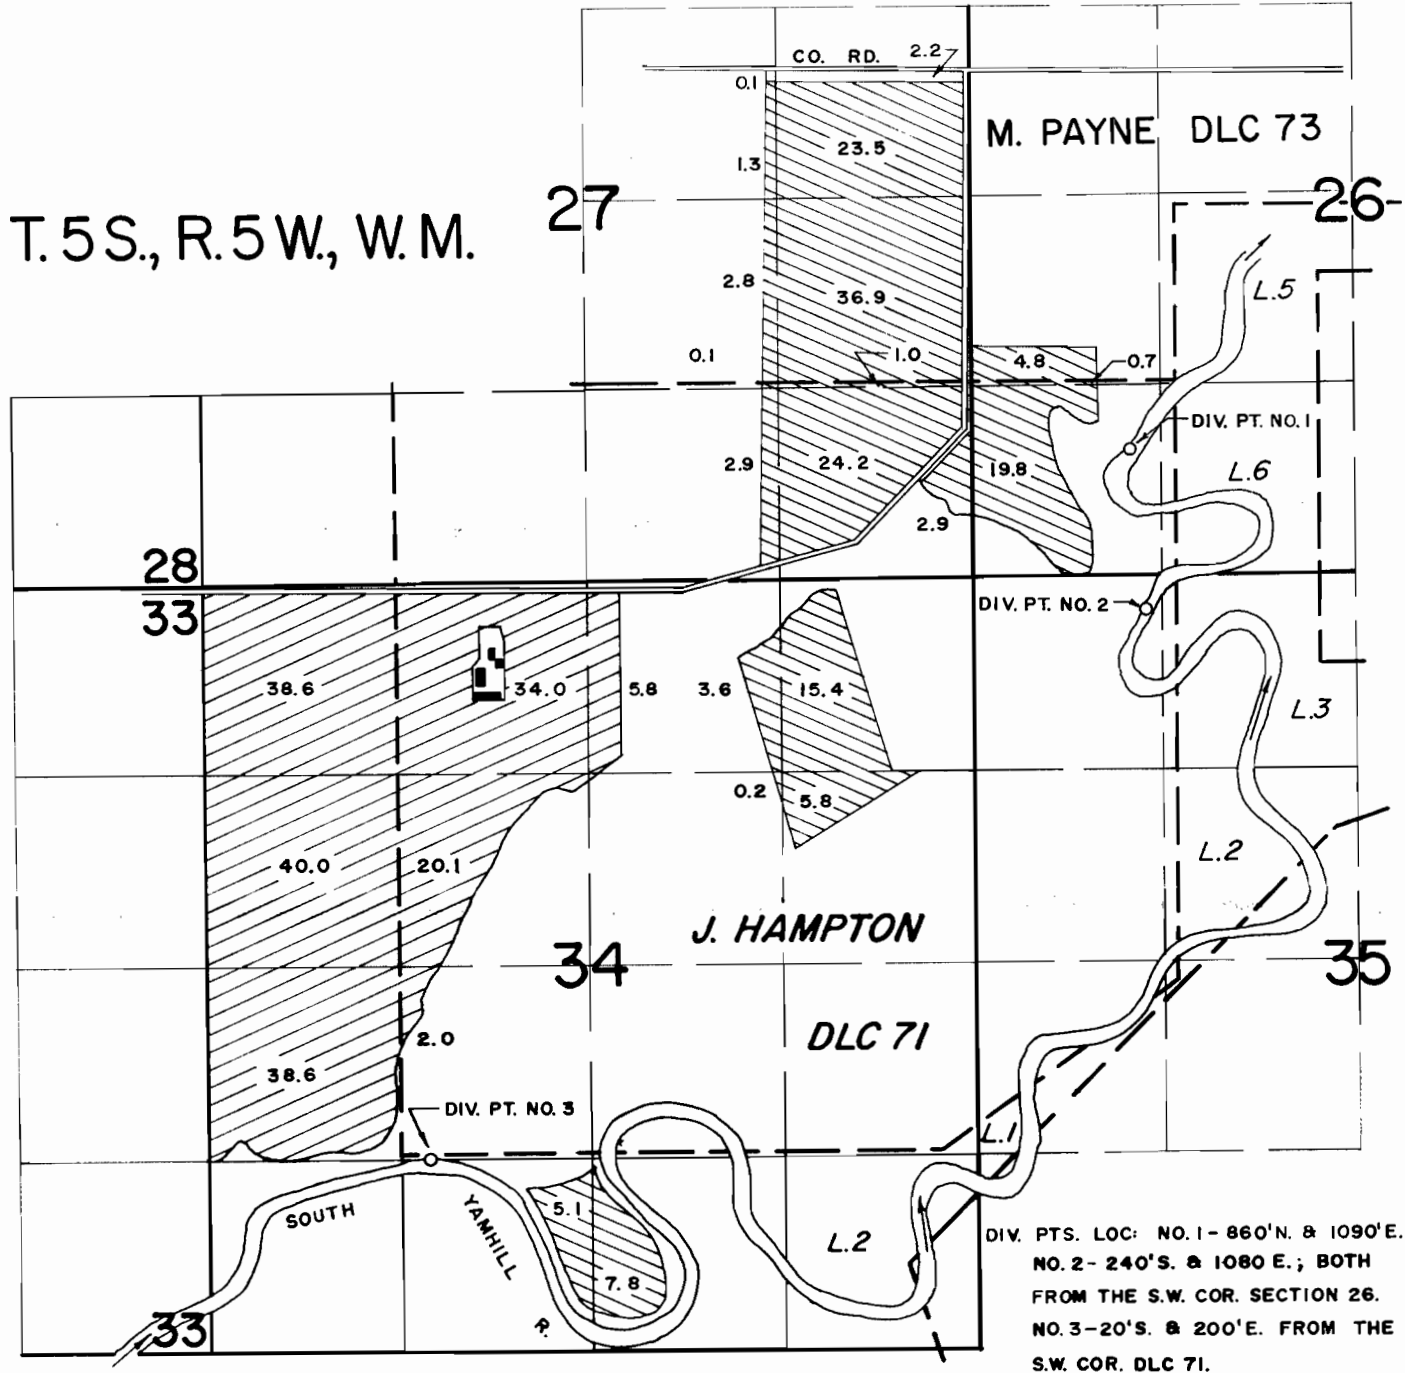

DIV. PTS. LOC: NO.1- 860'N. & 1090'E.;
 NO.2- 240'S. & 1080 E.; BOTH
 FROM THE S.W. COR. SECTION 26.
 NO.3-20'S. & 200'E. FROM THE
 S.W. COR. DLC 71.

 PERMIT NO. 43966

 PERMIT NO. 47681

**FINAL PROOF SURVEY
 UNDER**

58374 43966
 APPLICATION NO. 65280 PERMIT NO. 47681

CRIMSON WEST FARMS, INC.

SURVEYED OCTOBER 2, 1984 BY *P. Pagter*



SCALE: 4" = 1 MILE