RECEIVED
JAN 10 2011
WATER RESOURCES DEPT
SALEM, OREGON

T 13 S, R 1 W, Sec. 13
tax lot 140

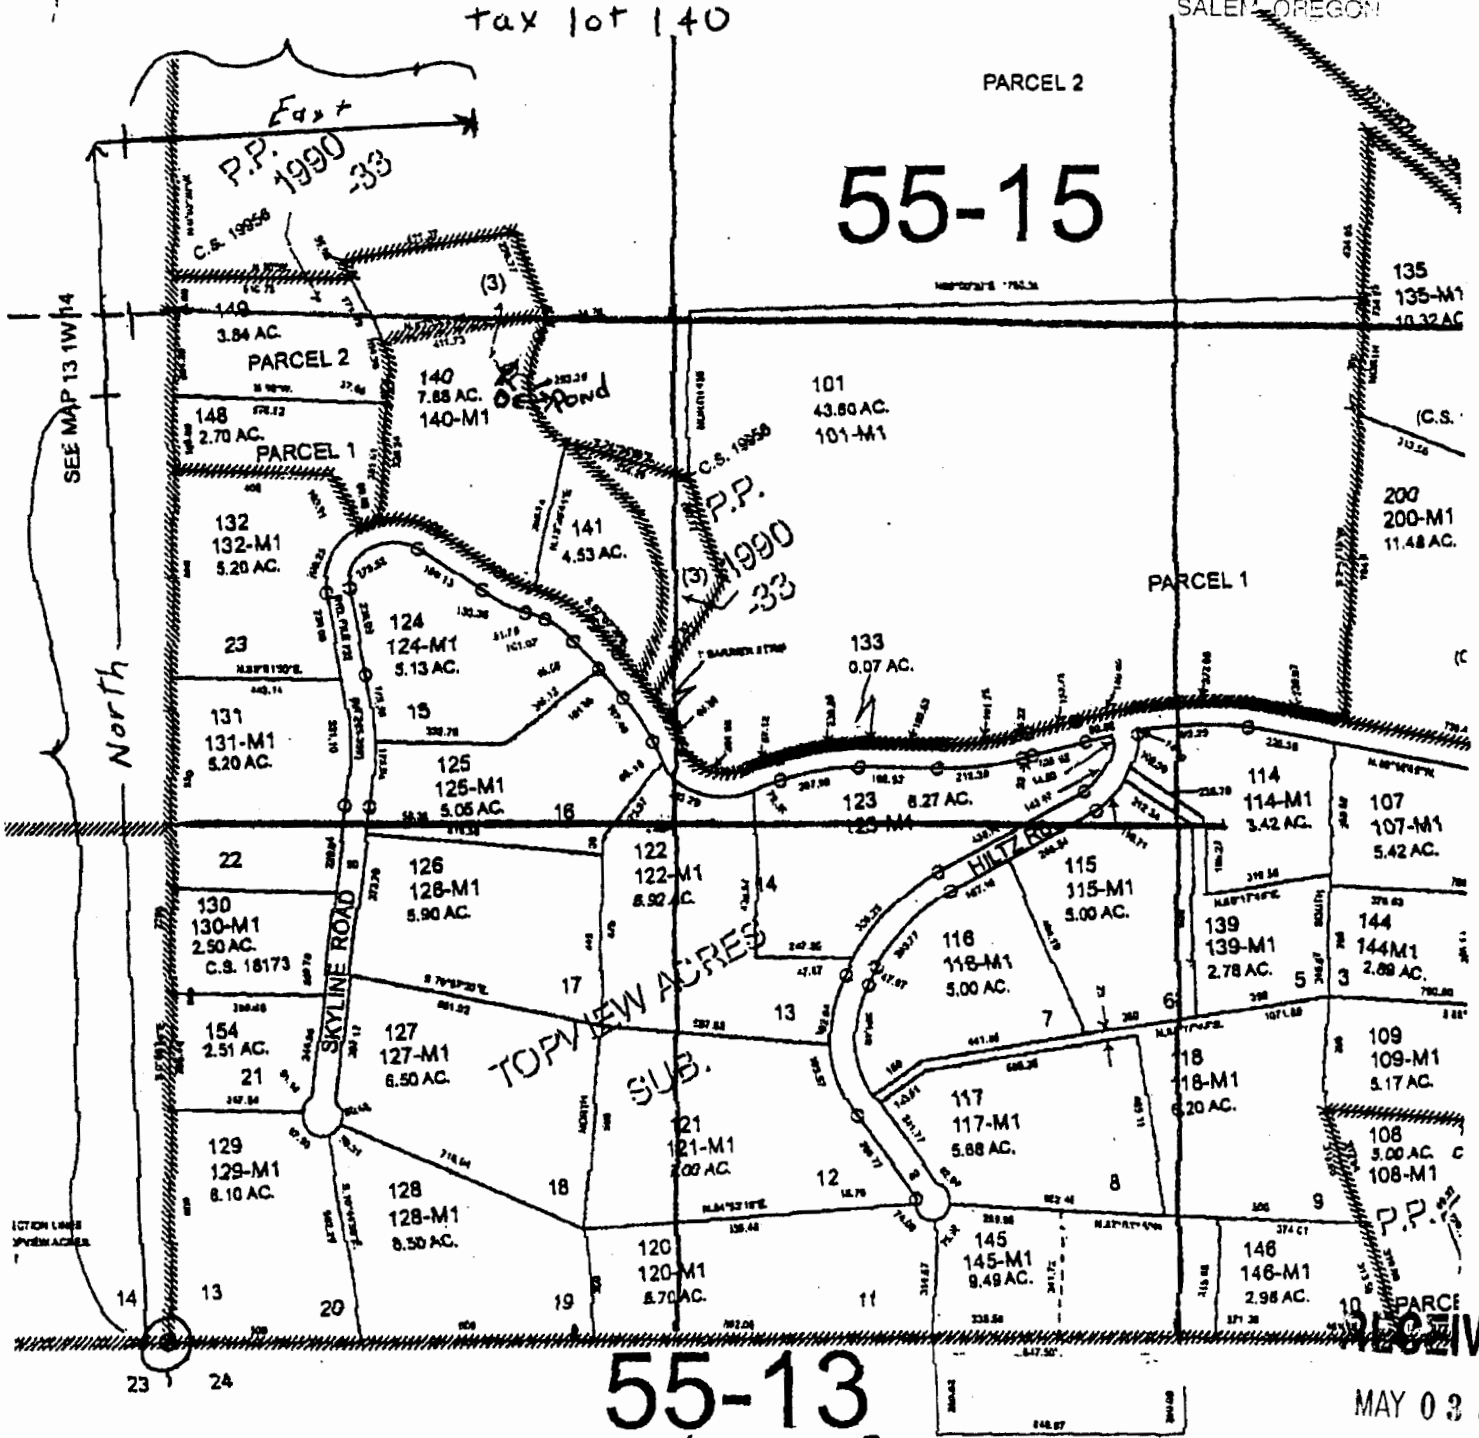

RECEIVED
MAY 03 2011
WATER RESOURCES DEPT
SALEM, OREGON

Pond in NW 1/4, SW 1/4 Sec 13

2,469 ft. North and 4,000 ft. East from SW Corner

SEE MAP 13 1W 24

N

RECEIVED
FEB 26 2010
WATER RESOURCES DEPT
SALEM, OREGON

1" = 500'

*'N' measurement corrected, see memo to file - mkm 1/10/11