

FINAL PROOF SURVEY MAP
IN THE NAME OF OREMET - ALLVAC
AUGUST 16, 2004

0150

HUTCHINS DLC 70
SE CORNER

SE 1/4 SW 1/4 S18

NE 1/4 NW 1/4 S19

SW 1/4 SW 1/4 S18

TAX LOT 900

TAX LOT 400

POINT OF USE
INDUSTRIAL
PURPOSES



POINT OF USE
POLLUTION
ABATEMENT

- LEGEND**
- - - TAX LOT BOUNDARIES
 - - - 6-INCH STEEL PIPE
 - - - 12-INCH STEEL PIPE
 - - - STEEL PIPE

- Notes:**
1. Points of appropriation are at the following locations:
Well No. 6 - 1060 feet South and 730 feet West from the SE corner of Hutchins DLC 70.
Well No. 7 - 2440 feet South and 25 feet West from the SE corner of Hutchins DLC 70.
Well No. 8 - 1940 feet South and 580 feet West from the SE corner of Hutchins DLC 70.
Well No. 10 - 1525 feet South and 1040 feet West from the SE corner of Hutchins DLC 70.
Well No. 11 - 1875 feet South and 403 feet East from the SE Corner of Hutchins DLC 70.
Well No. 12 - 1025 feet South and 172 feet East from the SE Corner of Hutchins DLC 70.
 2. Water supply wells are screened in a confined aquifer known as the WBZ-C Aquifer which extends from a depth of approximately 110 feet to 150 feet below ground surface.
 3. The maximum capacity observed for each water supply wells is below:
 - Well 6 = 146 GPM
 - Well 7 = 210 GPM
 - Well 8 = 340 GPM
 - Well 10 = 61 GPM
 - Well 11 = 234 GPM
 - Well 12 = 120 GPM
 4. TAXLOTS: #300, 400, 402, 900

TOWNSHIP: 11 SOUTH
RANGE: 3 WEST W.M.
APPLICATION NO. G-12277
PERMIT NO. G-11308

THE PURPOSE OF THIS MAP IS TO IDENTIFY A WATER RIGHT. IT IS NOT INTENDED TO PROVIDE LEGAL DIMENSIONS OR THE LOCATION OF PROPERTY LINES.

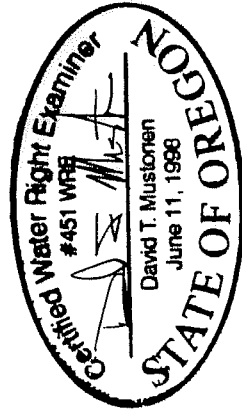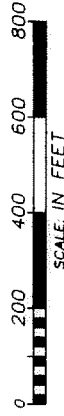

EXPIRES 12/31/04

FINAL PROOF MAP
FOR PERMIT #G11308
530 34TH S.W., ALBANY, OR 97321

CH2MHILL

COBU MAP #0150¹⁵⁰

