

Modified
12-12-14
OWRD - KKK

SCALE 1" = 1320'

The purpose of this map is for identifying the water right only and is not intended to provide legal dimensions of property ownership lines.


FINAL PROOF SURVEY

APPL. 71090 PER. 52094

IN NAME OF

Richard D. Stephens

SURVEYED SEPT. 18, 2000

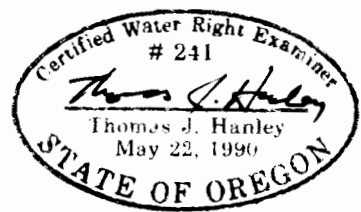

RECEIVED

001 02 2000

WATER RESOURCES DEPT.
SALEM, OREGON