

R. 33 E., W.M.

RECEIVED

MAY 29 1992

WATER RESOURCES DEPT.

UNDER

APPLICATION NO. G-12154
PERMIT NO. G-11230



APPLICATION NO. G-12377
PERMIT NO. G-11232

IN THE NAME OF

GERALD A. & ONA L. LINDSEY



T. 24 S.
T. 25 S.

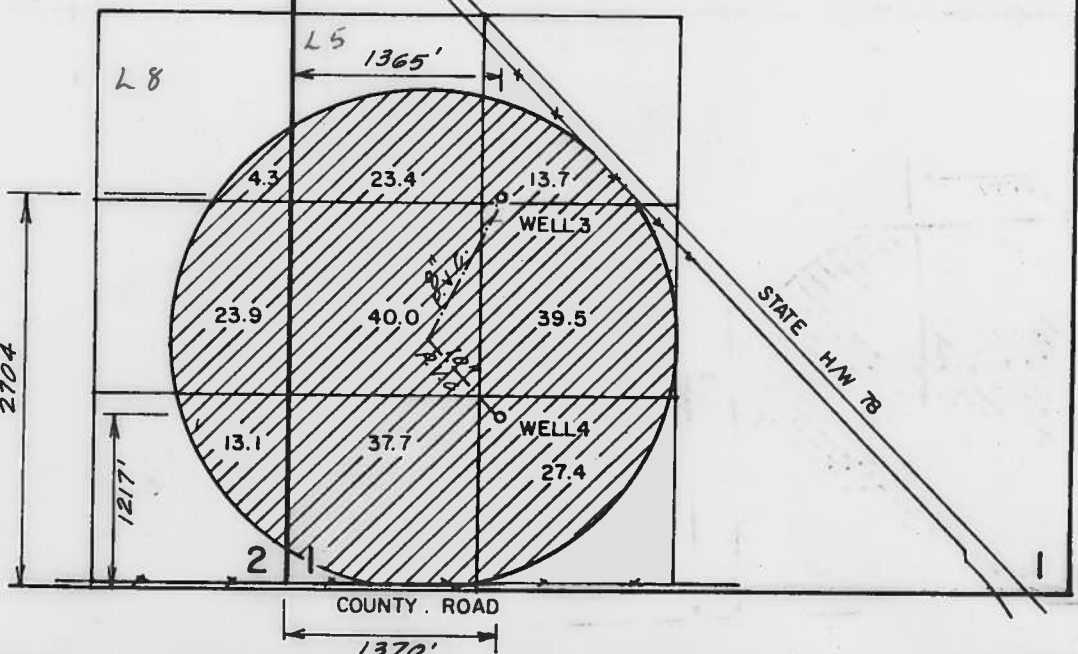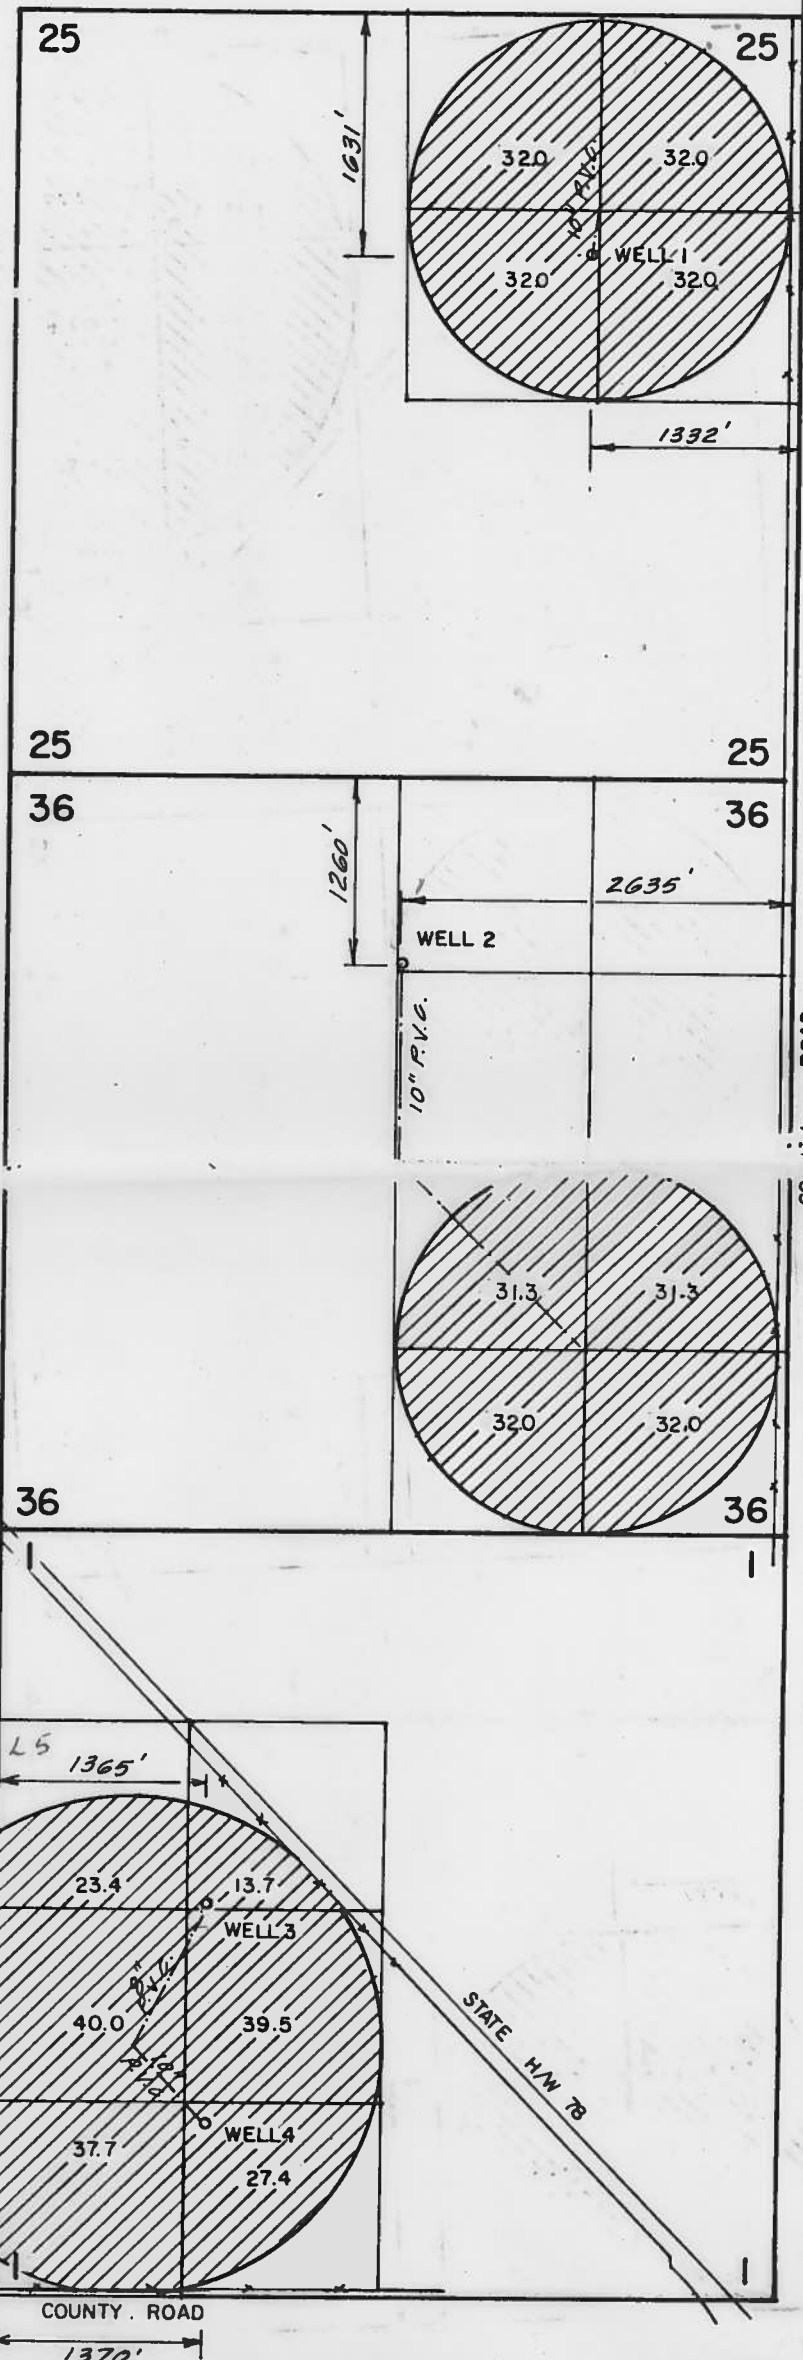

JWG 3-20-2009

	GERALD A. and ONA L. LINDSEY		BURNS, OR
	FINAL PROOF SURVEY		
	Scale: 4" = 1 mile	Date: Jan. 1992	Job: 1111
	Dsn:		Sht. No. /
Drn: CTP	of /		
Ckd:			