


Township 7 South, Range 2 West, W.M.

Portions of Sections 9, 10, 15 and 16

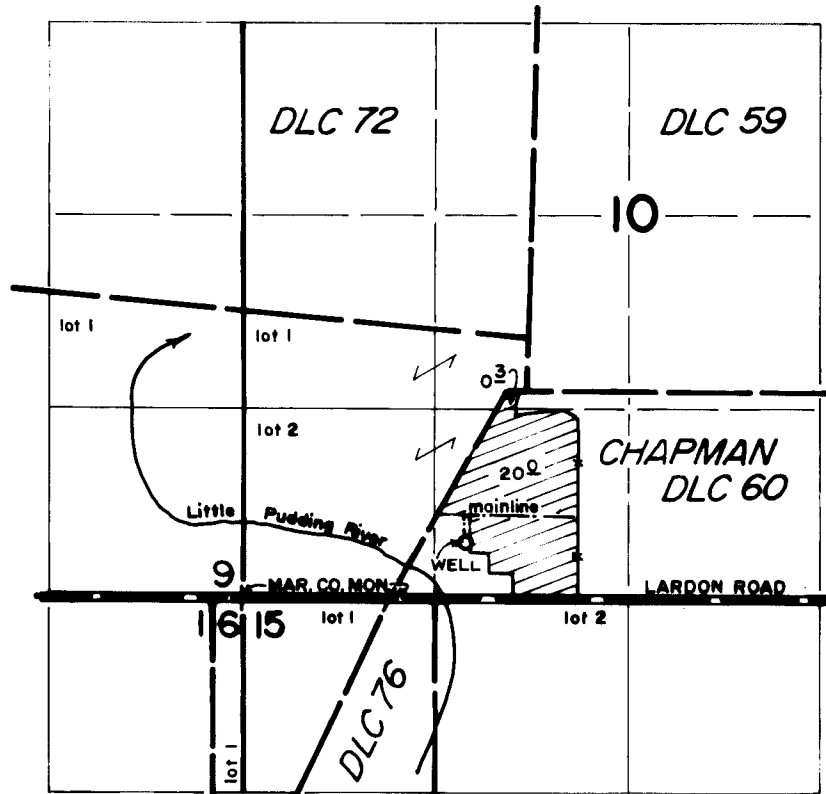


WELL LOCATED 380' N. AND 530' E. FROM SW COR. DLC 60.

FINAL PROOF SURVEY
under
Appl. No. G-12244, Per. No. G-11331
in name of

VERL L. HOLDEN
and
FLORENCE F. HARDESTY

October 7, 1994

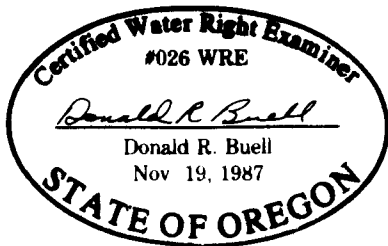

THIS MAP WAS PREPARED FOR THE PURPOSE OF IDENTIFYING THE LOCATION OF A WATER RIGHT ONLY AND IS NOT INTENDED TO PROVIDE LEGAL DIMENSIONS OR LOCATION OF PROPERTY OWNERSHIP LINES.