


T. 26 S., R. 4 W., W.M.

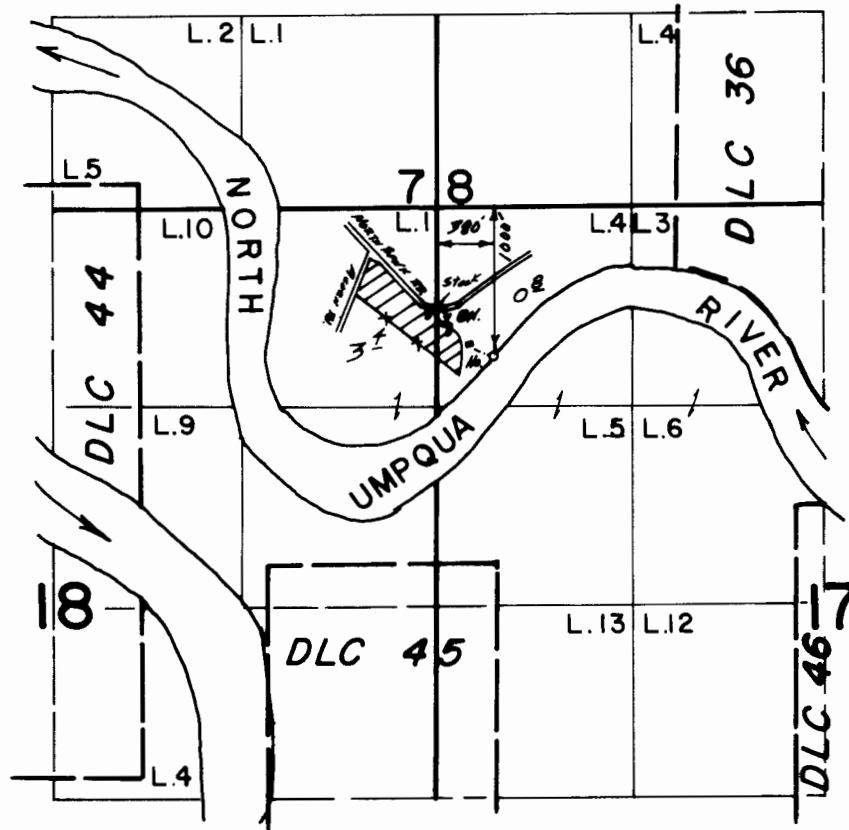

Scale 1"=1320'

**FINAL PROOF SURVEY  
UNDER**

Application No. 57430 Permit No. 43279....  
IN NAME OF

DALE W. SCHULTZ & NANCY LARSON

Surveyed Aug. 16, 1990, by B.S. James.....