


I, L.W. Coiner, of Cottage Grove Ore. do hereby certify that this map was made from notes taken during an actual survey made by me on Sept. 16, 1929, and that correctly represents the work described in the accompanying application, together with the location of streams and other ditches in the immediate vicinity.

L. W. Coiner

Registered Professional Engineer

Date of Registration Nov. 6, 1925

Oregon No. 1307

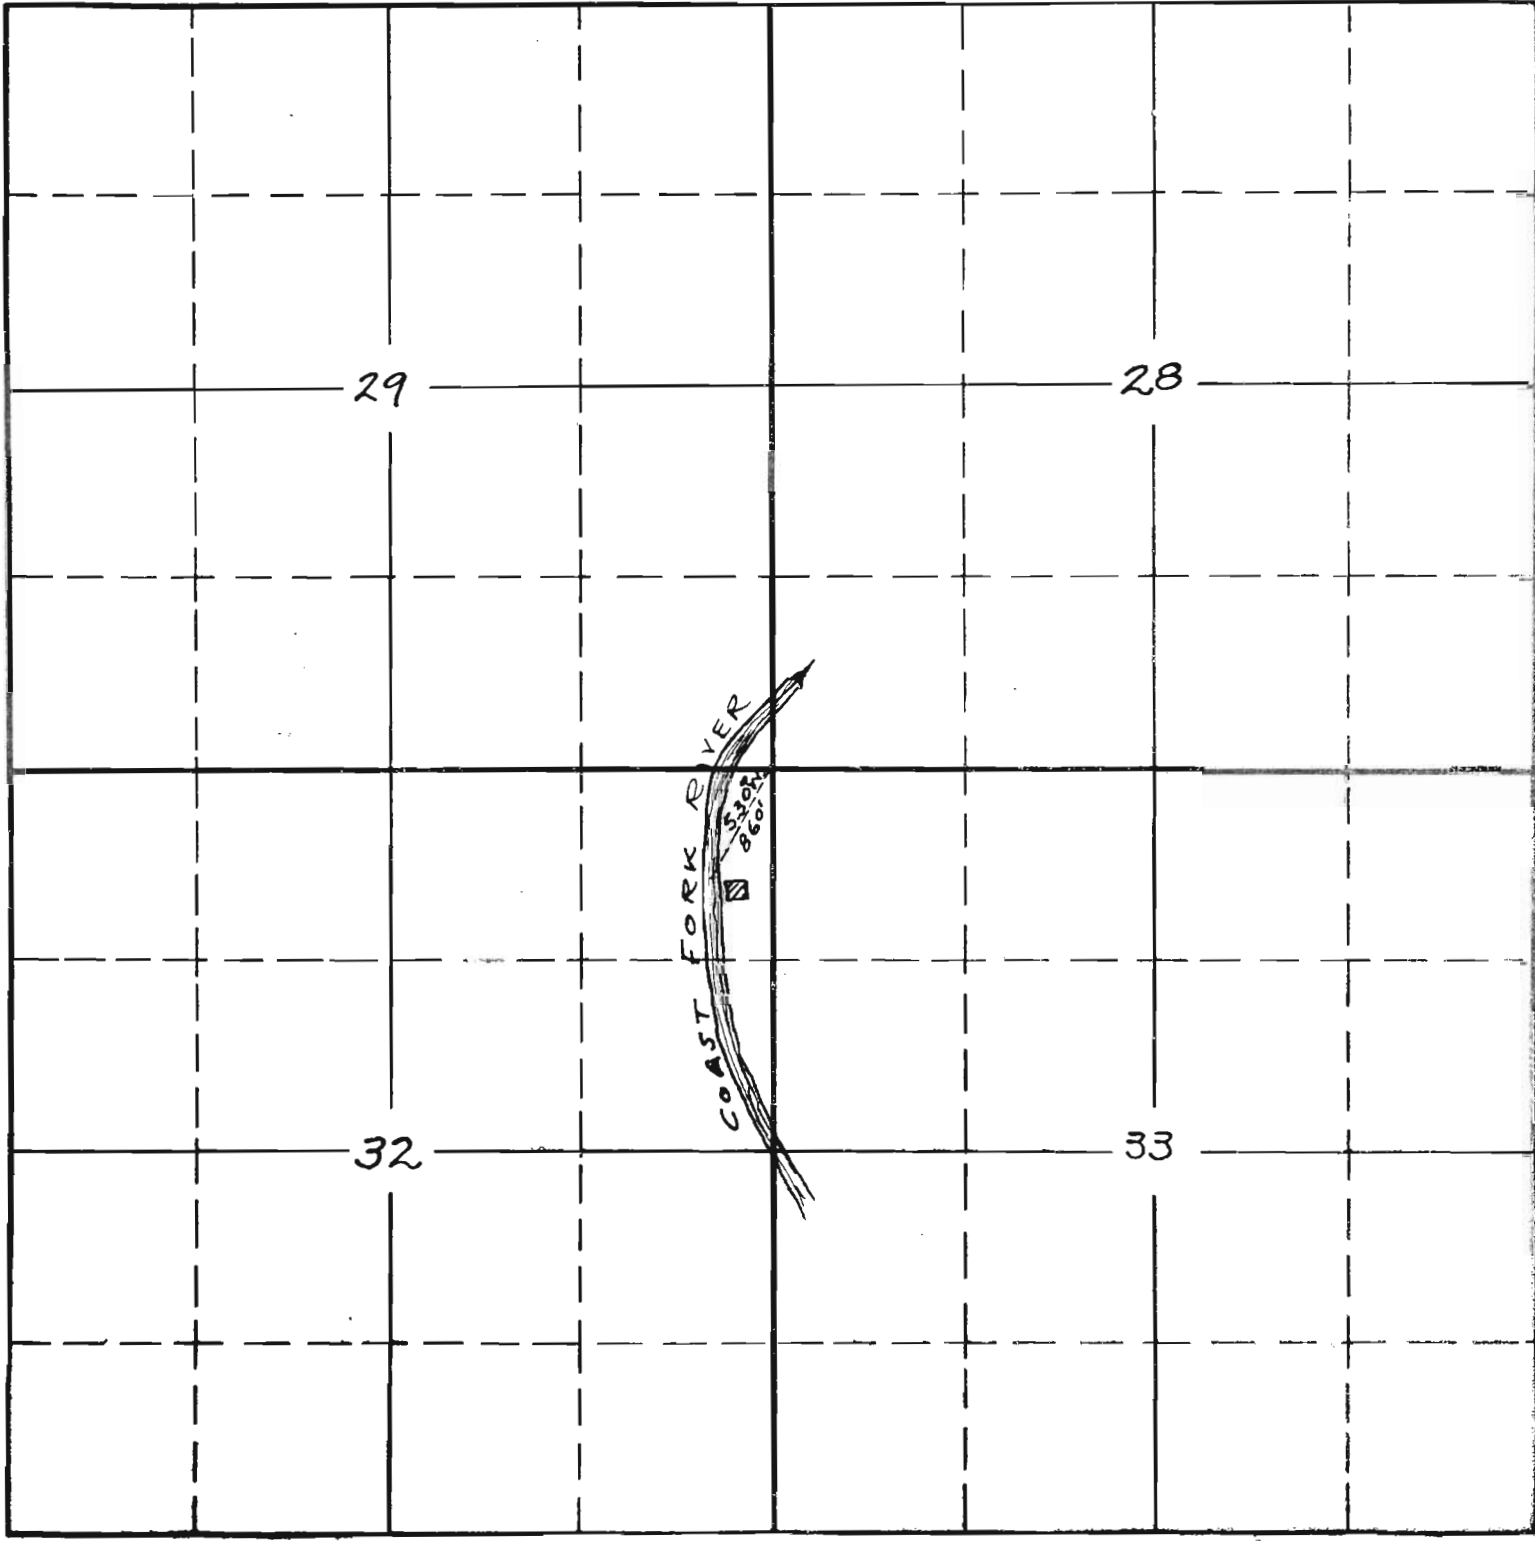

Sec. 32

N.E. 1/4  
of N.E. 1/4

Tp. 20 S.

R. 3 W.

Application No. 13,003  
Permit No. 9281