

CLAIM OF BENEFICIAL USE


APPLICATION R-71873 PERMIT R-12004
 APPLICATION S-71874 PERMIT S-52904

IN THE NAME OF BLANCO BOGS

SECTION 32, TOWNSHIP 31 SOUTH, RANGE 15 WEST, W.M.
 AND

SECTION 5, TOWNSHIP 32 SOUTH, RANGE 15 WEST, W.M.

CURRY COUNTY OREGON

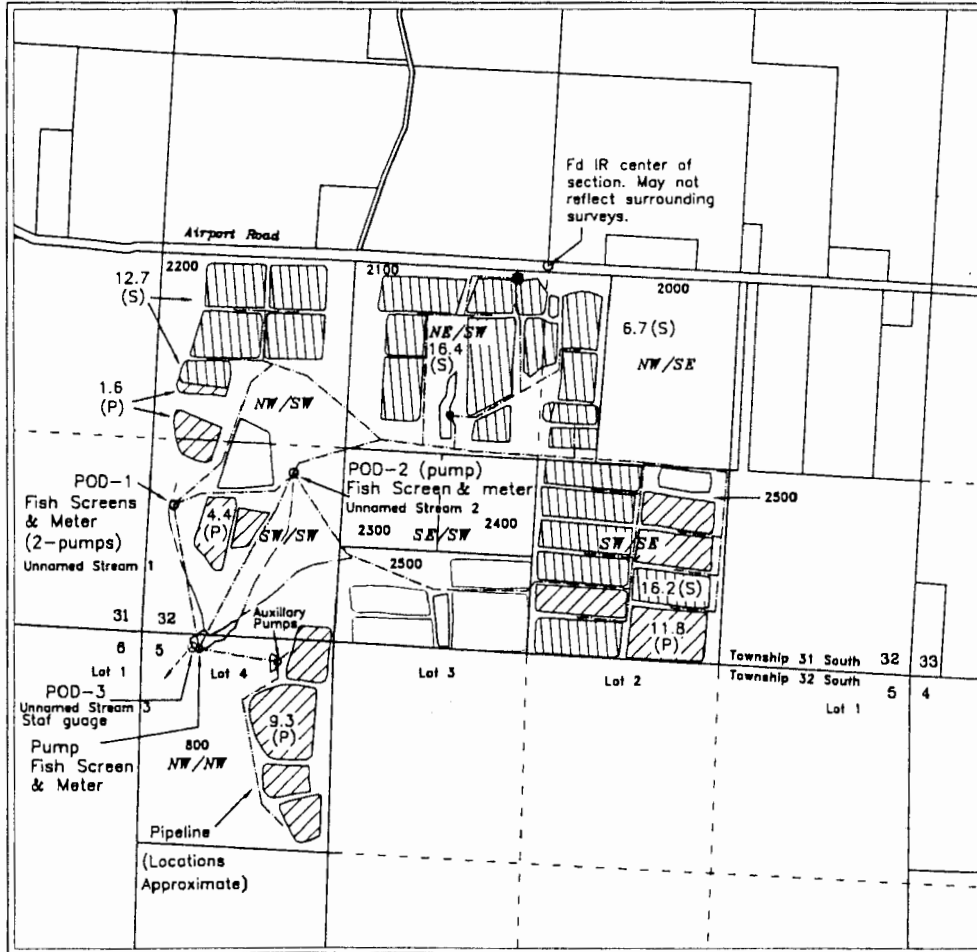

REVISION OF COBU MAP
 SUBMITTED 9/25/2000
 CORRECTING PLACE OF USE,
 PRIMARY VS SUPPLEMENTAL
 AND REDISCRPTION OF
 POINTS OF DIVERSION 1 & 3



Scale
 1 inch = 1320 feet

RECEIVED


MAY 10 2012

WATER RESOURCES DEPT
 SALEM, OREGON

POD-1, UNNAMED STREAM #1, SW/SW SECTION 32, 880 FEET NORTH & 170 FEET EAST
 POD-2, UNNAMED STREAM #2, SW/SW SECTION 32, 1130 FEET NORTH & 980 FEET EAST
 BOTH FROM THE SW CORNER OF SECTION 32

POD-3, UNNAMED STREAM #3 & RESERVOIR, NW/NW SECTION 5, 90 FEET SOUTH &
 355 FEET EAST FROM THE NW CORNER OF SECTION 5

- (P) Primary Cranberry Operations - 27.1 Acres
 Supplemented by Reservoir
- (S) Supplemental Cranberry Operations - 52.0 Acres
- Reservoir - 3.5 Acre-Feet, Supplemental
 Cranberry Operations

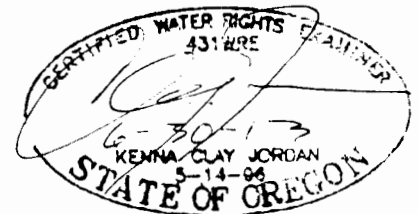

This map is not intended to provide legal dimensions
 or locations of property ownership lines

Base map from Curry County
 GIS over 2005 FSA aerial photo
 for assumed best fit and
 adjusted to closely fit
 previous COBU and Final Proof
 Survey maps

JORDAN ENGINEERING
 460 JORDAN LANE
 ROSEBURG, OR 97471
 (541) 673-1931

6/10/2011 n.e.d.
 Revised 4/24/2012 n.e.d.
 5-1-12 KCJ