


# CLAIM OF BENEFICIAL USE

APPLICATION R-71873      PERMIT R-12004  
 APPLICATION S-71874      PERMIT S-52904

IN THE NAME OF BLANCO BOGS

SECTION 32, TOWNSHIP 31 SOUTH, RANGE 15 WEST, W.M.  
 AND  
 SECTION 5, TOWNSHIP 32 SOUTH, RANGE 15 WEST, W.M.

CURRY COUNTY OREGON

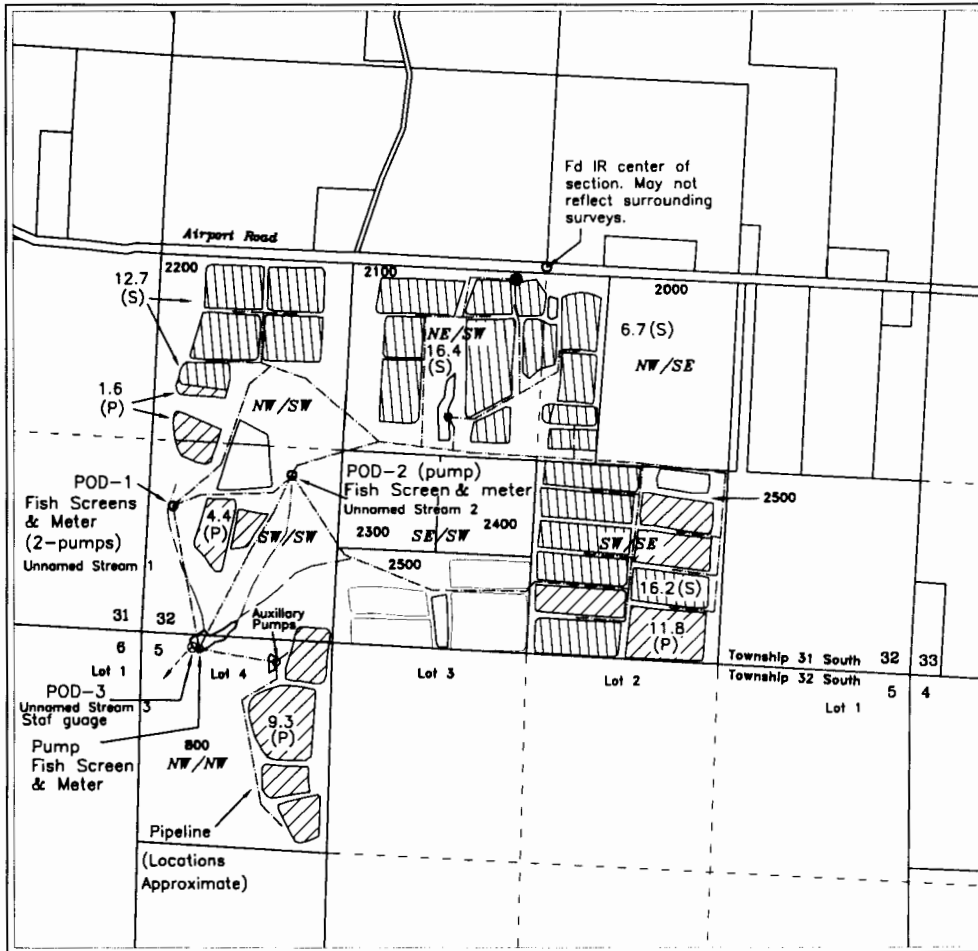

REVISION OF COBU MAP  
 SUBMITTED 9/25/2000  
 CORRECTING PLACE OF USE,  
 PRIMARY VS SUPPLEMENTAL  
 AND REDISCRPTION OF  
 POINTS OF DIVERSION 1 & 3



Scale  
 1 inch = 1320 feet


**RECEIVED**  
**MAY 10 2012**

**WATER RESOURCES DEPT**  
**SALEM, OREGON**

POD-1, UNNAMED STREAM #1, SW/SW SECTION 32, 880 FEET NORTH & 170 FEET EAST  
 POD-2, UNNAMED STREAM #2, SW/SW SECTION 32, 1130 FEET NORTH & 980 FEET EAST  
 BOTH FROM THE SW CORNER OF SECTION 32

POD-3, UNNAMED STREAM #3 & RESERVOIR, NW/NW SECTION 5, 90 FEET SOUTH &  
 355 FEET EAST FROM THE NW CORNER OF SECTION 5

- (P) Primary Cranberry Operations - 27.1 Acres  
Supplemented by Reservoir
- (S) Supplemental Cranberry Operations - 52.0 Acres
- Reservoir - 3.5 Acre-Feet, Supplemental  
Cranberry Operations

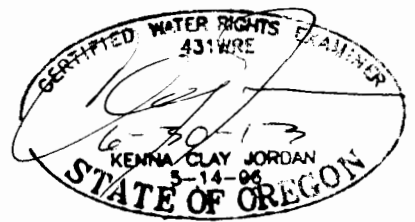

This map is not intended to provide legal dimensions  
 or locations of property ownership lines

Base map from Curry County  
 GIS over 2005 FSA aerial photo  
 for assumed best fit and  
 adjusted to closely fit  
 previous COBU and Final Proof  
 Survey maps

JORDAN ENGINEERING  
 460 JORDAN LANE  
 ROSEBURG, OR 97471  
 (541) 673-1931  
 6/10/2011 n.e.d.  
 Revised 4/24/2012 n.e.d.  
 5-1-12 KCJ