
T.3S., R.1W., W.M.



1''= 1320

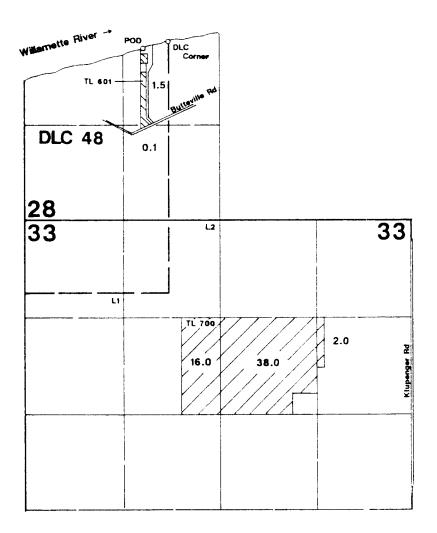



Primary Area Irrigated

POD is located 100'N & 8'E from a point located S74° 29' 20"W 426.29' from NE corner DLC 48.

## **Final Proof Survey**

In Name Of

## **Klupenger Nursery**

Application #: S-80145

Permit #: 52747

Surveyed on September 15, 2000 by JM Schuette



This Map Was Prepared For The Purpose Of Identifying The Location Of AWate r Right Only And Is Not Intended To Provide Legal Dimensions Or Location Of Property Ownership Lines.