


T. 3 S., R. 3 W., W.M.

Location: The SE 1/4 and SW 1/4 of the NW 1/4 of Section 4, Township 3 South, Range 3 West, Willamette Meridian, part of the Lewis Rogers Donation Land Claim No. 39, Yamhill County, Oregon.

I certify that the information I have provided in this Final Proof is an accurate representation of the actual water use and is true and correct to the best of my knowledge. It is to be used for the purpose of identifying the location of water right only and is not intended to provide legal dimensions or locations of property ownership lines.

Matt Dunckel

Matt Dunckel, C.W.R.E.

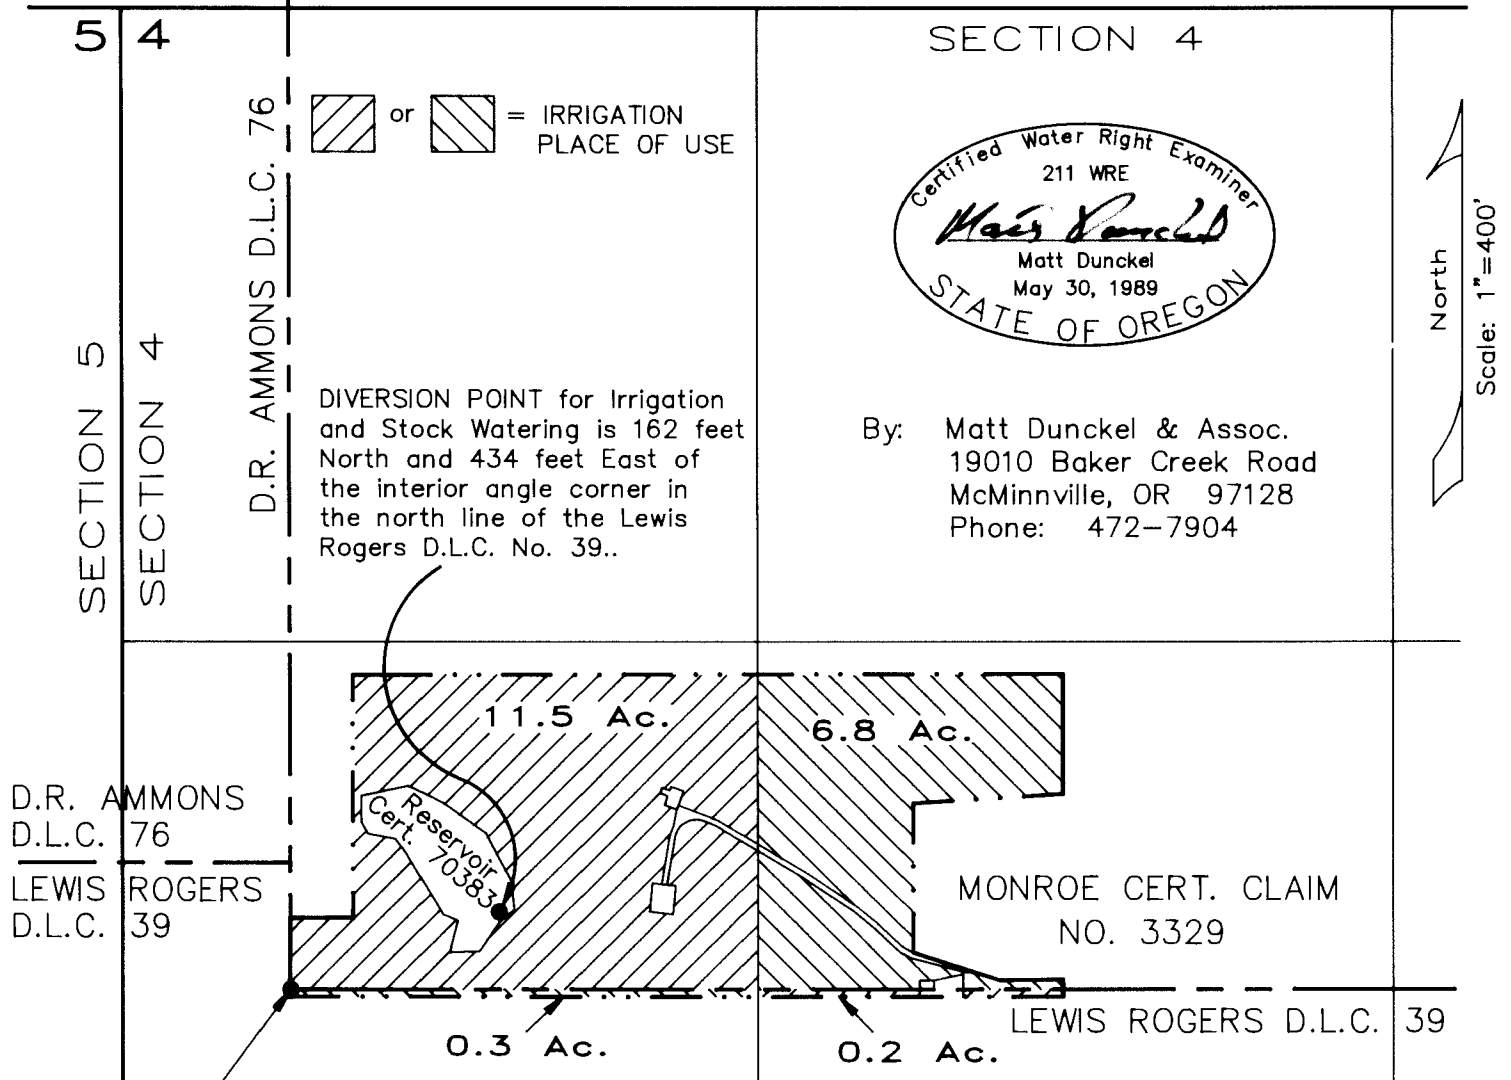

Interior Angle corner in the north line of the Lewis Rogers D.L.C. No. 39. Found 24" Oak Tree with Blaze marks.

FINAL PROOF SURVEY

UNDER

Application No. S-76443 Permit No. S-52439

IN NAME OF

REGINALD R. MAAS

Surveyed September 15, 1999

RECEIVED

SEP 25 1999

YAMHILL COUNTY RECORDS DEPT