


RECEIVED

DEC 26 1997

WATER RESOURCES DEPT
SALEM, OREGON

T.5S., R.1E., W.M.

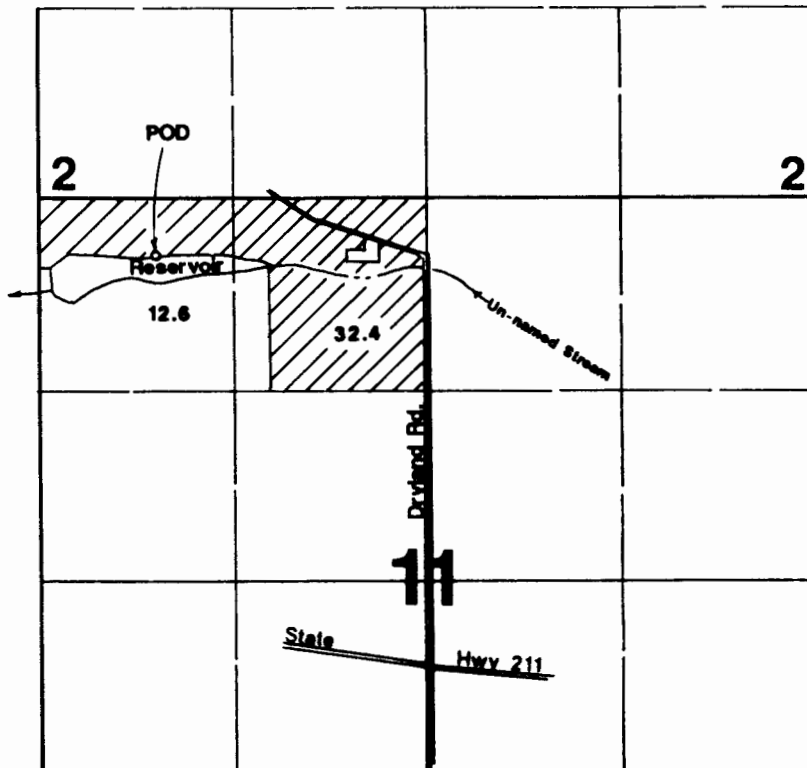

1" = 1320'



POD located 400'S & 800'E from NW corner Section 2.

Final Proof Survey

Application #: 73311


Permit #: 51646

In Name Of

Howard Laney/Cygnnet Group

Surveyed November 25, 1997 by JM Schuette

THIS MAP WAS PREPARED FOR THE PURPOSE OF IDENTIFYING THE LOCATION OF A WATER RIGHT ONLY AND IS NOT INTENDED TO PROVIDE LEGAL DIMENSIONS OR LOCATION OF PROPERTY OWNERSHIP LINES.

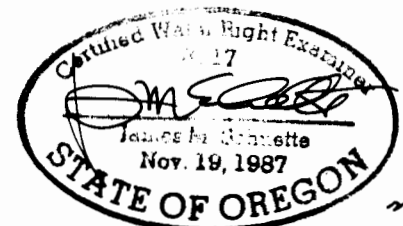

12-11-14
MB/wrd