

# AMENDED FINAL PROOF SURVEY MAP

AUG - 6 1997

IN THE NAME OF RUSSELL FRASER


WATER RESOURCES DEPT.  
SALEM, OREGON

SECTION 13, TOWNSHIP 30 SOUTH, RANGE 15 WEST, W.M.

APPLICATION R-69549  
APPLICATION 69550

PERMIT R-11036  
PERMIT 50529


DRWG. 97-34

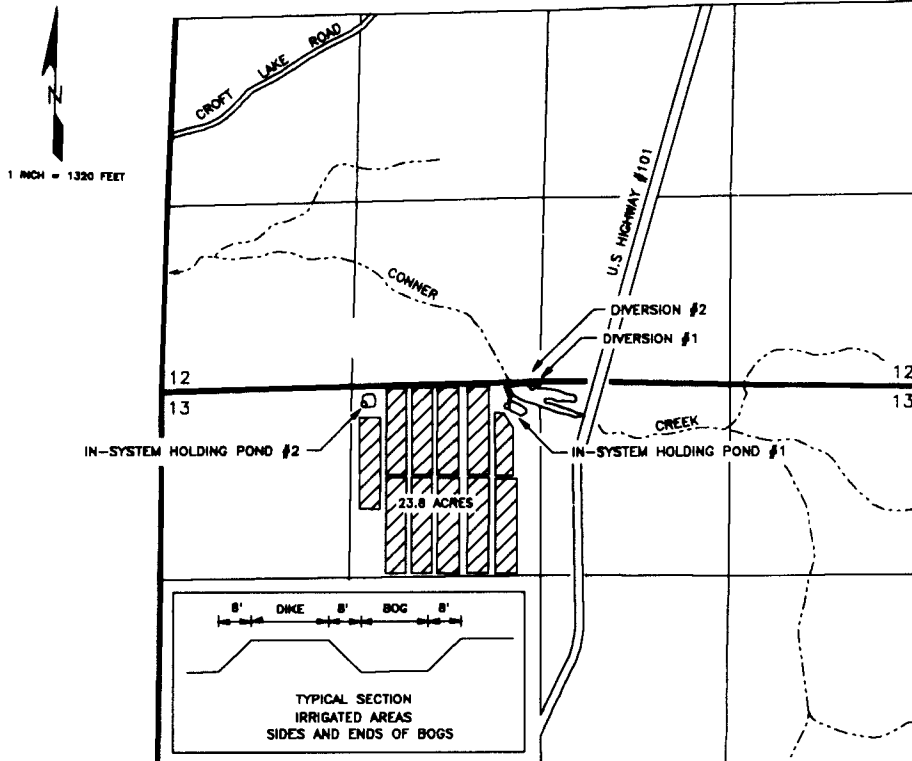

- CRANBERRY IRRIGATION, FLOOD HARVEST AND TEMPERATURE CONTROL : 23.8 ACRES
- IRRIGATION : 2.2 ACRES

*located on the sides and ends of each bog.*

*JC WRD  
12/9/2014*

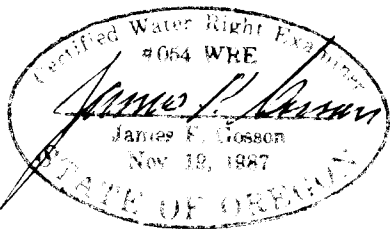

**DIVERSION #1** IS LOCATED 45 FEET SOUTH AND 50 FEET WEST; **DIVERSION #2** IS LOCATED 35 FEET SOUTH AND 200 FEET WEST, BOTH BEING FROM THE NORTH 1/4 CORNER OF SECTION 13, BOTH BEING WITHIN THE NE1/4 NW1/4 OF SECTION 13, TOWNSHIP 30 SOUTH, RANGE 15 WEST, W.M., COOS COUNTY.

THE PURPOSE OF THIS MAP IS TO IDENTIFY THE LOCATION OF THE WATER RIGHT. IT IS NOT INTENDED TO PROVIDE INFORMATION RELATIVE TO THE LOCATION OF PROPERTY OWNERSHIP BOUNDARY LINES.