

T.2N., R.9W., W.M.

SE 1/4 SW 1/4
SEC 32, T3N, R9W

BRASS
CAP

31 32 T.3N.
6 5 T.2N.

32 1/4
5

GOV'T
LOT
4

GOV'T
LOT
3

FOSS-BATTERSON COUNTY ROAD

RAIL ROAD

NEHALEM RIVER

2" PVC
PIPELINE

3" PVC
PIPELINE

TANK

CONCRETE
PLANT

PETERSON
CREEK

TL 800

TL 200

TL 1100

TL 1100

873'

894'

DIV. PT. #1

DIV. PT. #2

SCALE:
1" = 400'

W 1/16

NW 1/16

CN 1/16

FINAL PROOF SURVEY


UNDER

APPLICATION NO. 70857, PERMIT NO. 52219

IN THE NAME OF

MOHLER SAND & GRAVEL CO.

SURVEYED MAY 3, 2000

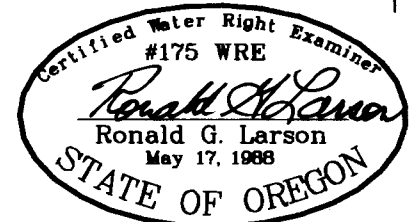

RENEWAL DATE: DECEMBER 31, 2000

FILE: 0367-11087-03-01.FLX

THE PURPOSE OF THIS MAP IS TO IDENTIFY THE LOCATION OF THE WATER RIGHT. IT IS NOT INTENDED TO PROVIDE INFORMATION RELATIVE TO THE LOCATION OF PROPER OWNERSHIP BOUNDARY LINES.

RECEIVED

HLB & ASSOCIATES, INC.
SURVEYING • ENGINEERING • PLANNING

4253A HWY 101 N.
GEARHART, OR 97138
(503) 738-3425
FAX: (503) 738-7455

OCT 09 2000