

SCALE: 1" = 400'

RECEIVED

SEP 01 1999

WATER RESOURCES DEPT.
SALEM, OREGON



MUDDY CK →

POINT OF DIVERSION

FROM MUDDY CREEK IS
SOUTH 620' & EAST 170' FROM
THE SLY SW COR OF DLC. No. 51

SLY SW CORNER
JOSEPH ROBINETT
P.L.C. No. 51

MUDDY

CREEK

SE 1/4, SW 1/4
SEC. 7

TL 201

POWER POLE
20.7 ACRES

IRRIGATION
LINE

6.7 AC.

NE 1/4, NW 1/4
SEC. 18

SW 1/4, SE 1/4

TL 200

8.9 AC.

7.6 AC.

NW 1/4, NE 1/4

TL 10

TL 103

NE 1/4, NE 1/4

7 8
18 17

Map of Beneficial Use
Under
APPLICATION S-73297

in the name of

KENT and DEANNA STOCKWELL
29141 Lamb Drive
Albany, OR 97321

Date of Site Inspection: July 22, 1998
Date of Map: August 24, 1998

Tax Lot: 201 (12-4W-18)
Source: Willamette Basin Project Reservoirs
constructed under Permit R-5363, Tributary
to the McKenzie River


Area of Irrigation

Under S-73297, there are 43.9 acres being put to beneficial
use as specified by quarter-quarter sections on the herein
attached map.

I, JACK R. BURRELL, BEING DULY SWORN AS A WATER
RIGHT EXAMINER, LICENSE NO. 209, HAVE PREPARED THIS
MAP FOR KENT AND DEANNA STOCKWELL ON THIS 25TH
DAY OF AUGUST 1998. THE AREAS HATCHED REPRESENT
THE ACREAGE'S BEING IRRIGATED AT THE TIME OF THE
SITE INSPECTION CONDUCTED ON JULY 22, 1998.

PREPARATION OF THIS MAP IS FOR THE PURPOSE OF
IDENTIFYING THE LOCATION OF THE WATER RIGHT ONLY
AND HAS NO INTENT TO PROVIDE DIMENSIONS OR
LOCATION OF PROPERTY OWNERSHIP LINES.

NOTE: Point of Diversion from McKenzie River is
located South 4440' and East 5250' of the SE corner
of the Mansfield DLC No. 79, being within the NE
1/4 of the NE 1/4, Sec. 9, T. 17 S., R. 3 W.,
W.M., Lane County, Oregon and under Armitage
Bridge.

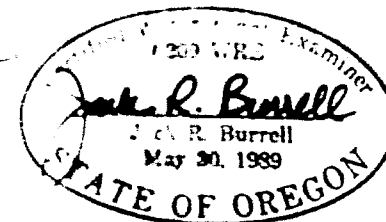

EXPIRATION DATE: 12/31/99

KD ENGINEERING, INC.
202 NW HICKORY STREET
POST OFFICE BOX 725
ALBANY, OREGON 97321

SECS 1 & 18, T. 17 S., R. 3 W., LINN COUNTY, OREGON

DSGN. BY:

DWG. BY: M.M.S.

CKD. BY: J.R.B.

SCALE: 1" = 400'

DATE: AUGUST 24, 1998

PROJECT NO.: 93-18

SHEET NO.

ONE
OF
ONE