


T.5S., R.1E., W.M

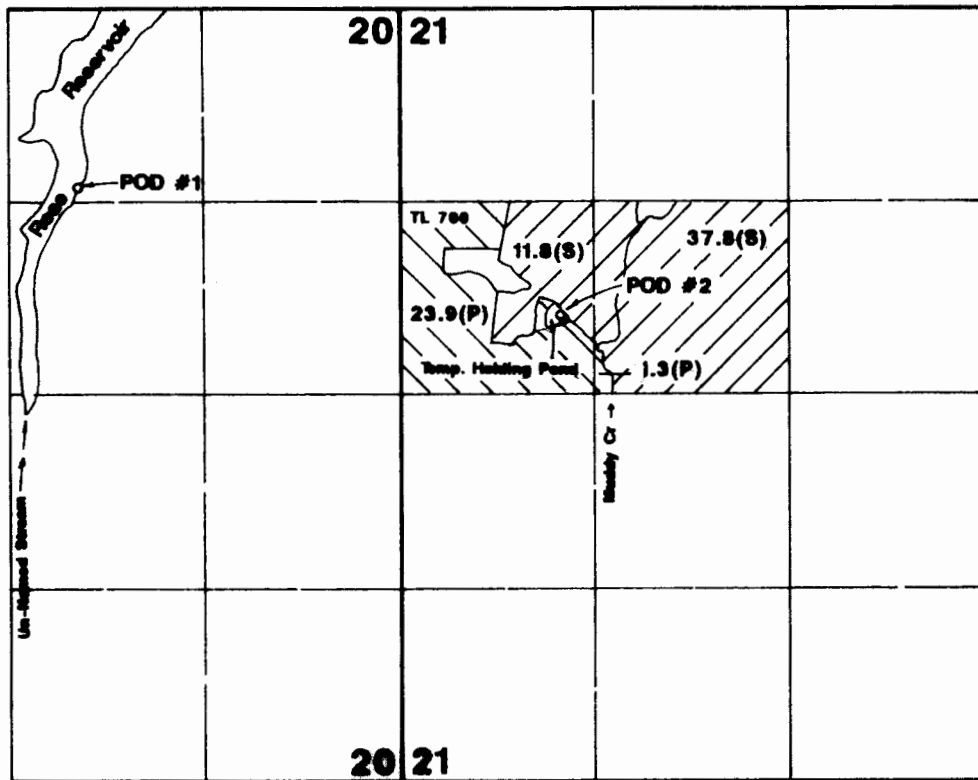

POD #1 is located 1430'N & 2180'W

POD #2 is located 570'N & 1100'E both from the E1/4 corner of Section 20.

Final Proof Survey


Application: S-81035

Permit #: 53077

In Name Of

Roselawn Seed Co.

Surveyed on September 21, 2002 by JM Schuette

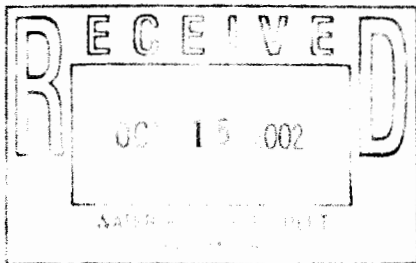

This Map Was Prepared For The Purpose Of Identifying The Location Of A Water Right Only And Is Not Intended To Provide Legal Dimensions Or Location Of Property Ownership Lines.

