



# T.5S. R.2W., W.M

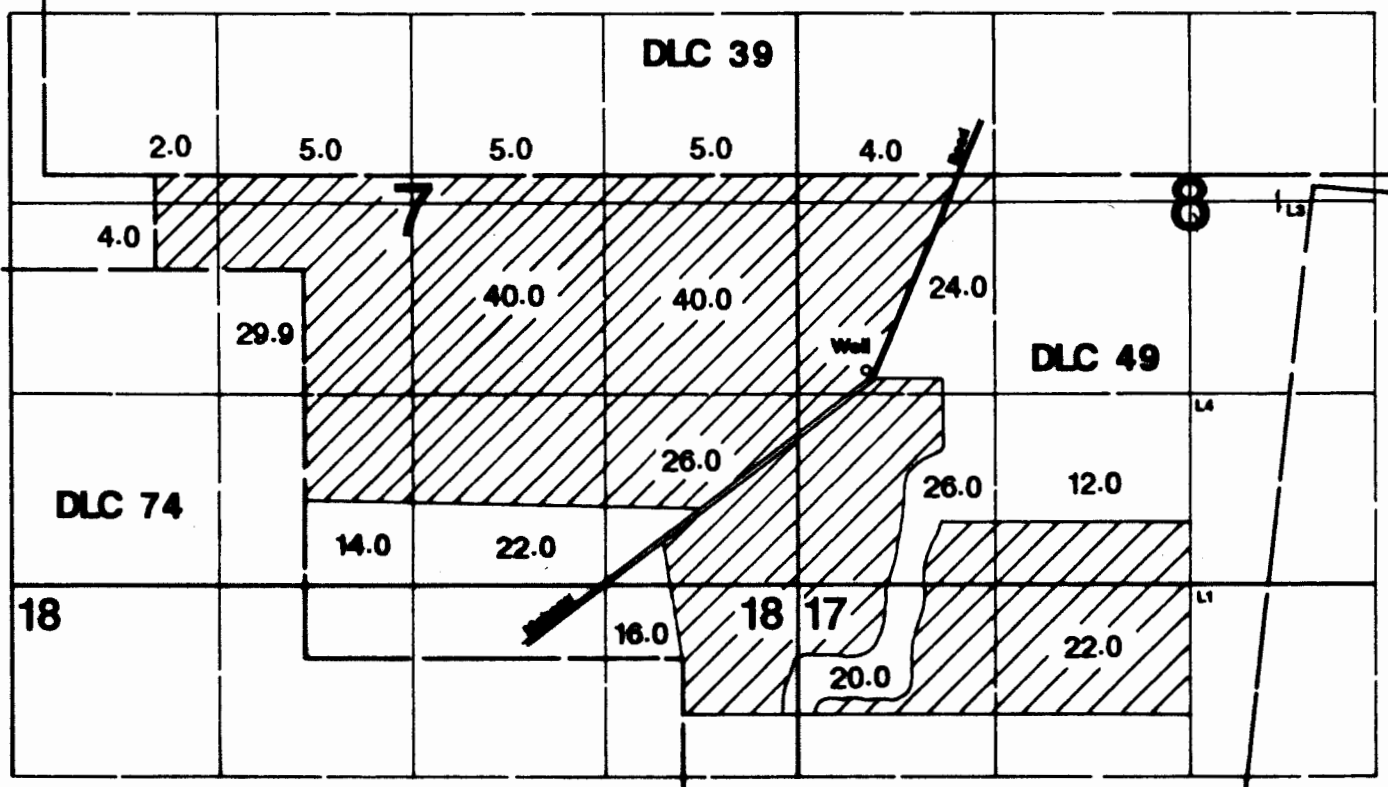

Well is located 1150'S & 450'E from the W1/4 corner of Section 8.

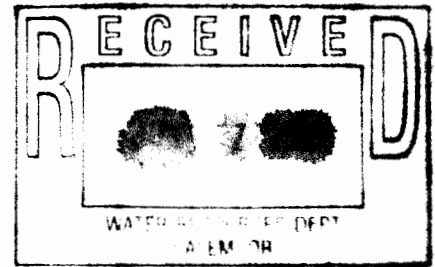

Area Irrigated

## Final Proof Survey

Application #: G-13484 Permit #: G-13437

In Name Of

### Paul J. Kirsch

Surveyed on May 23, 2000 by JM Schuette

This Map Was Prepared For The Purpose Of Identifying The Location Of A Water Right Only And Is Not Intended To Provide Legal Dimensions Or Location Of Property Ownership Lines.

