


CLAIM OF BENEFICIAL USE  
SURVEYED OCTOBER 17, 2002  
BY DUANE W. KIRBY  
FOR GAIL ROTHROCK  
APPLICATION NO. S-84683  
PERMIT NO. S-53846  
T27S, R6W, W.M.  
SECTION 22  
TAX LOT 500



SCALE 1" = 400'

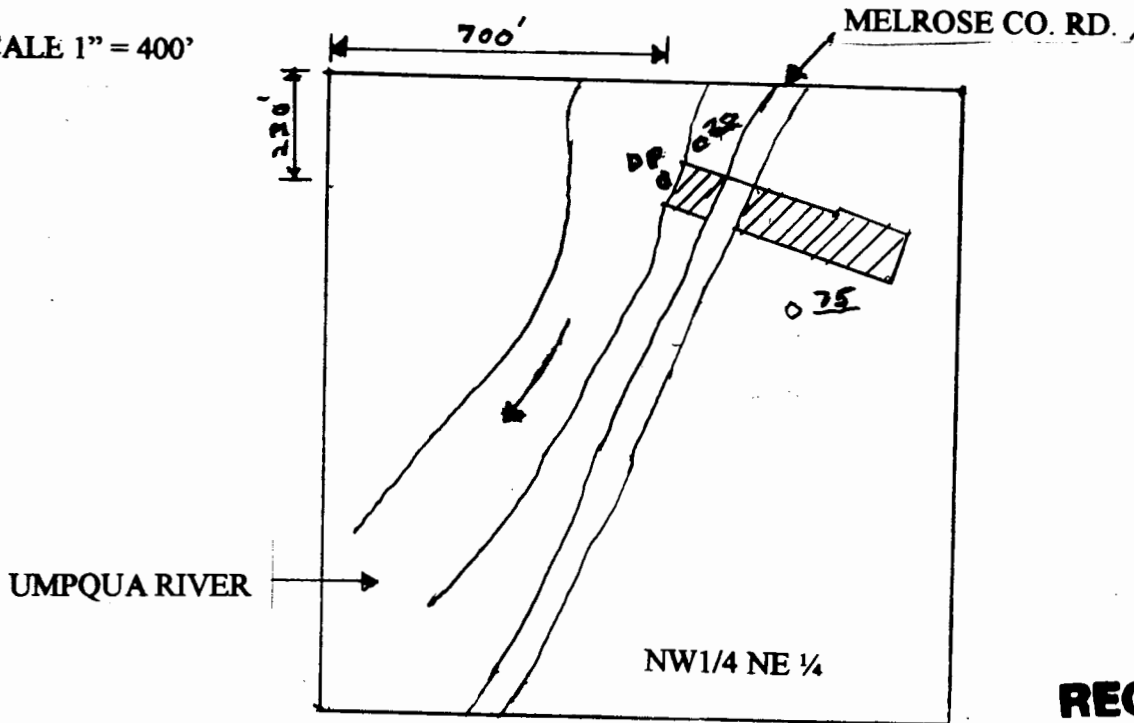

**RECEIVED**

OCT 23 2002

WATER RESOURCES DEPT  
SALEM, OREGON

THE PURPOSE OF THIS MAP IS TO IDENTIFY THE LOCATION OF THE WATER RIGHT. IT IS NOT INTENDED TO PROVIDE INFORMATION RELATIVE TO THE LOCATION OF PROPERTY OWNERSHIP BOUNDARY LINES.

