


T.9&10S.R.2W.W.M.

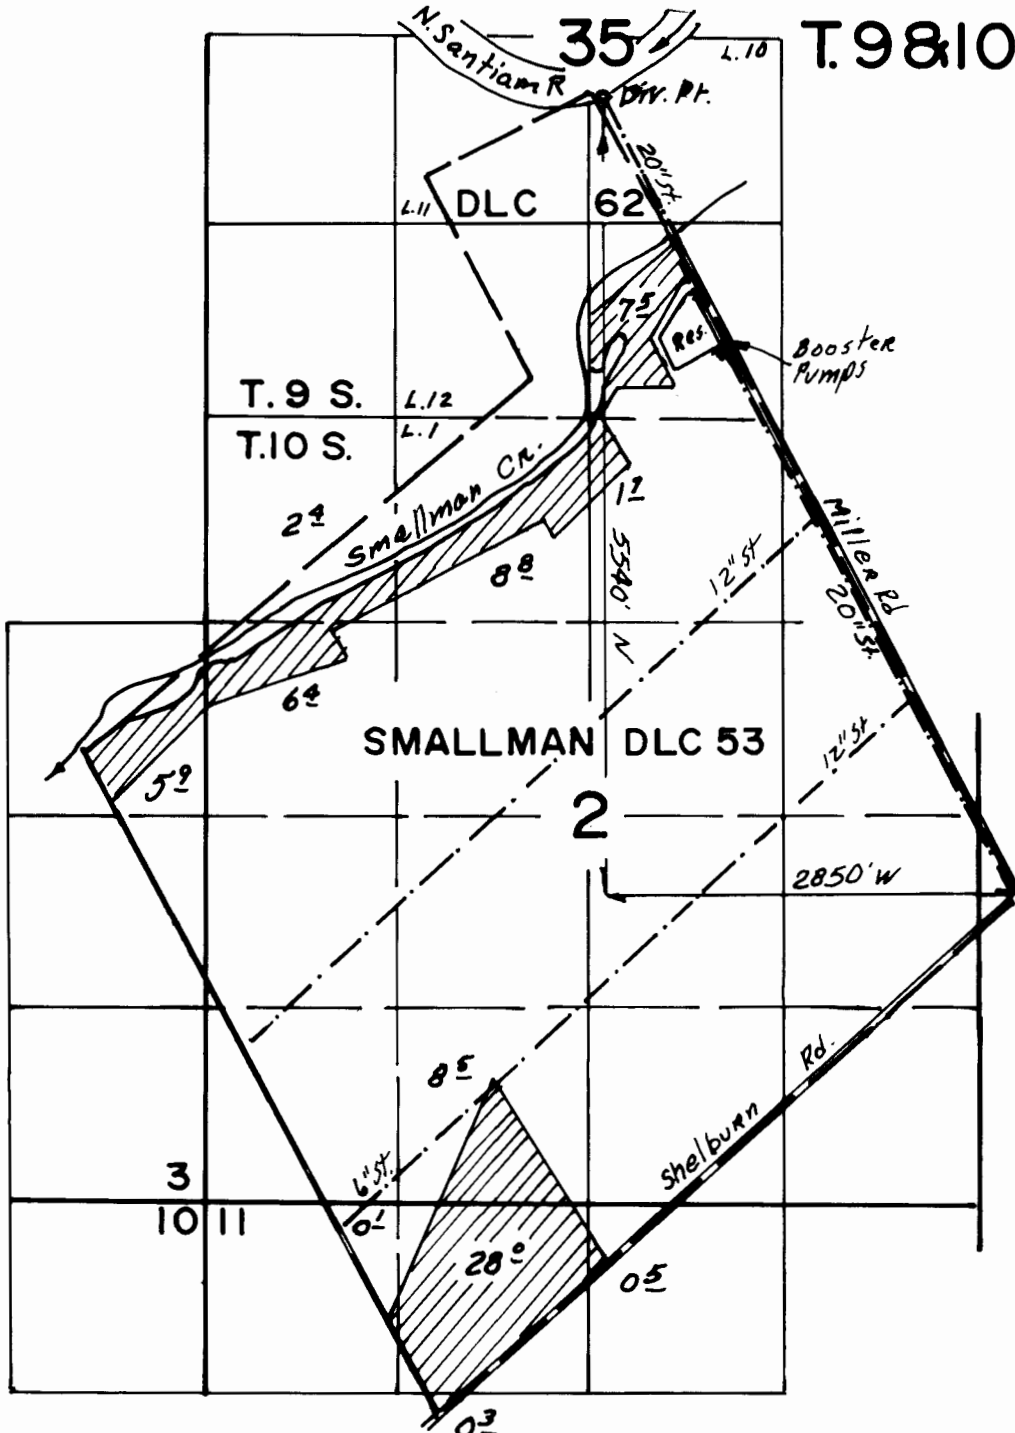

North Arrow
Scale
4" = 1 Mi.

FINAL PROOF SURVEY
UNDER

73217 52043
Application No. ~~73389~~ Permit No. ~~52044~~
IN NAME OF

..M.T. JEFFERSON FARMS.....

Surveyed P.E.C. 30 19.99, by

THIS MAP WAS PREPARED FOR THE PURPOSE OF IDENTIFYING THE LOCATION OF A WATER RIGHT ONLY AND IS NOT INTENDED TO PROVIDE LEGAL DIMENSIONS OR LOCATION OF PROPERTY OWNERSHIP LINES.

