


T.5S., R.2W., W.M.

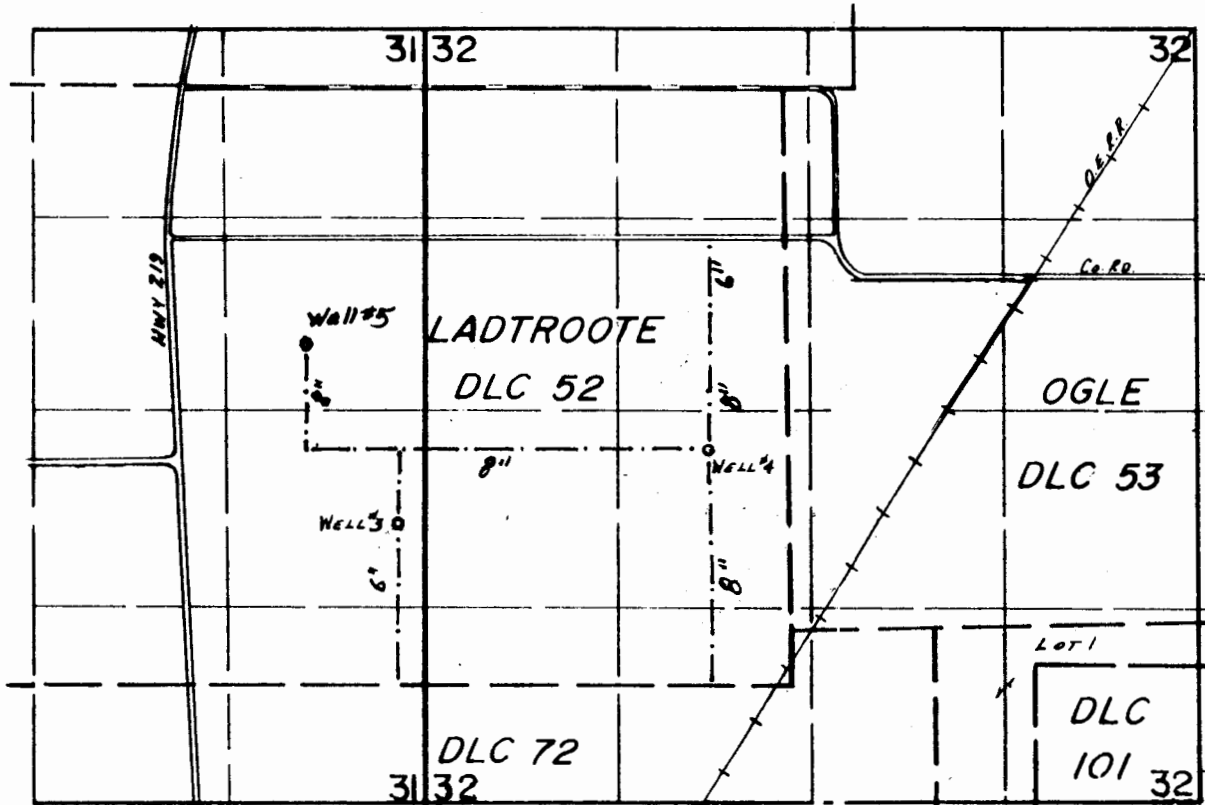

WELLS LOC.: #3- 3000'S. & 2640' W., #4- 2500'S. & 520' W., BOTH FROM NE COR. LADTROOTE DLC 52.  
#5 450' N & 800' W FROM E 1/4 COR. SEC. 31


SCALE: 1"=1320'

**FINAL PROOF SURVEY  
UNDER**

**Transfer No. T-7988  
IN THE NAME OF**

**ROBERT & PAMELA ZIELINSKI**

**Surveyed July 17, 2001, by**

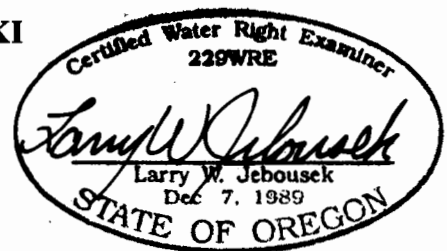

THIS MAP WAS PREPARED FOR THE PURPOSE OF IDENTIFYING THE LOCATION OF A WATER RIGHT ONLY AND IS NOT INTENDED TO PROVIDE LEGAL DIMENSIONS OR LOCATION OF PROPERTY OWNERSHIP LINES.